

898.03


NOTE: THIS MAP NOT TO SCALE
 SEE SURVEY MAP BY
 JAMES POWERS - BRUNSWICK SURVEY
 CL. 1: 76923
 PRIOR INST. -

-063
~~15.70 A.~~
 15.73 A.

18513-~~II~~

10/20/89
 # 18513-A

APPROVED
 LORAIN CO.
 MAP DEPT.
 DATE 7-10-89
 PAGE 12.00.000-B
 BY T. McMain
 VOID AFTER 18513-A

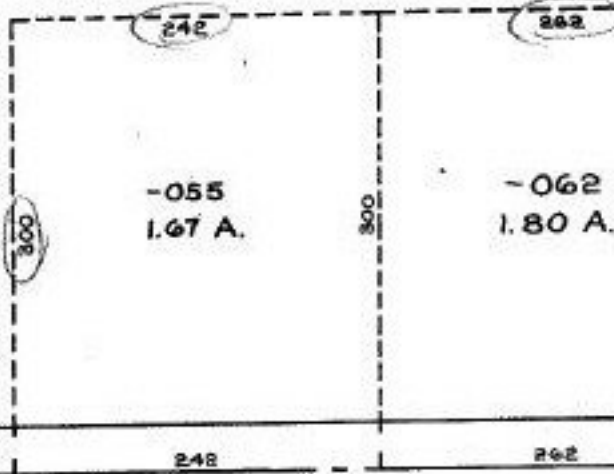

MARKS 300
 ACRES
 CORR.

957.50
 952.54

126.0
 AT

616.88

340.85

248

262

RD.

B