


1852

APPROVED
LORAIN CO.
MAP DEPT.
DATE 6-11-68
A-00-004-F
BY *Holler*

7-14-86 88

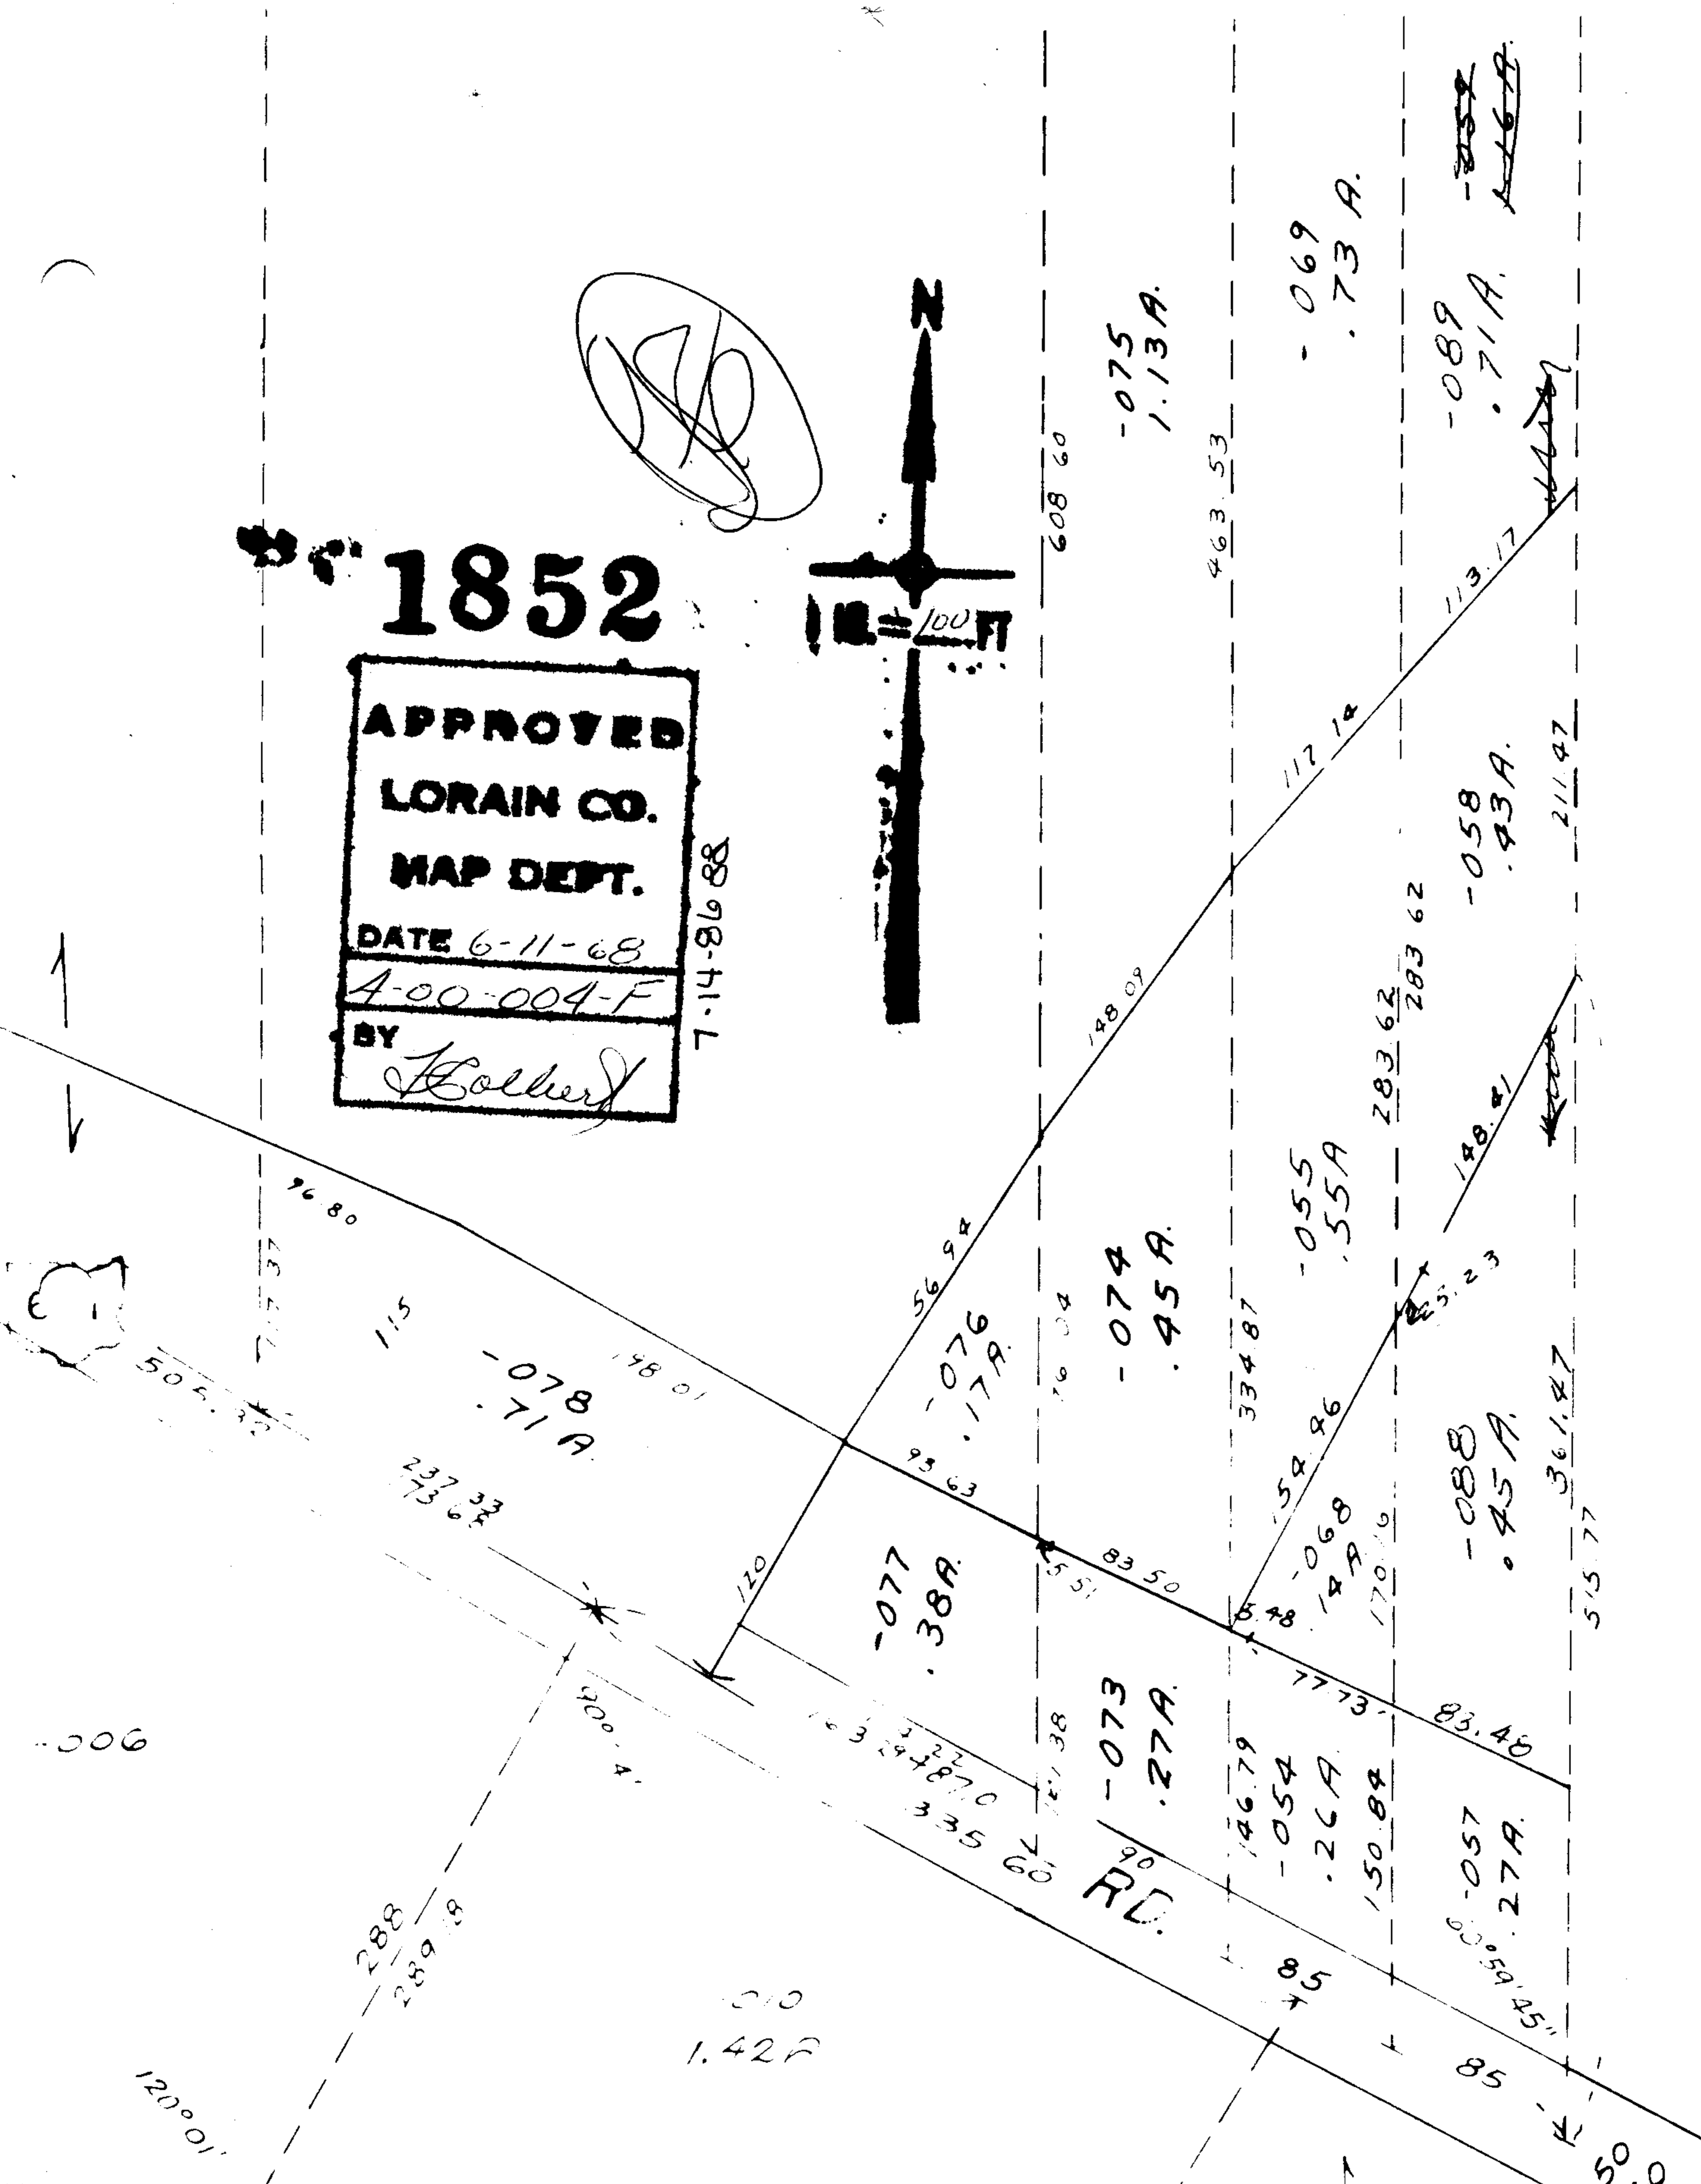

006

SEE 4-E

$\frac{116}{45} \frac{71}{71}$

DONE 7/6/68 W. Kochis

1852