


Pt. -001  
Pt. 19.50 A.

RD.

1.65 A  
0.80  
0.85

SEE SURVEY MAP  
SURVEY BY -  
P. A. MCGANNON  
CL. P. INF.  
PRIOR INST. 762/376

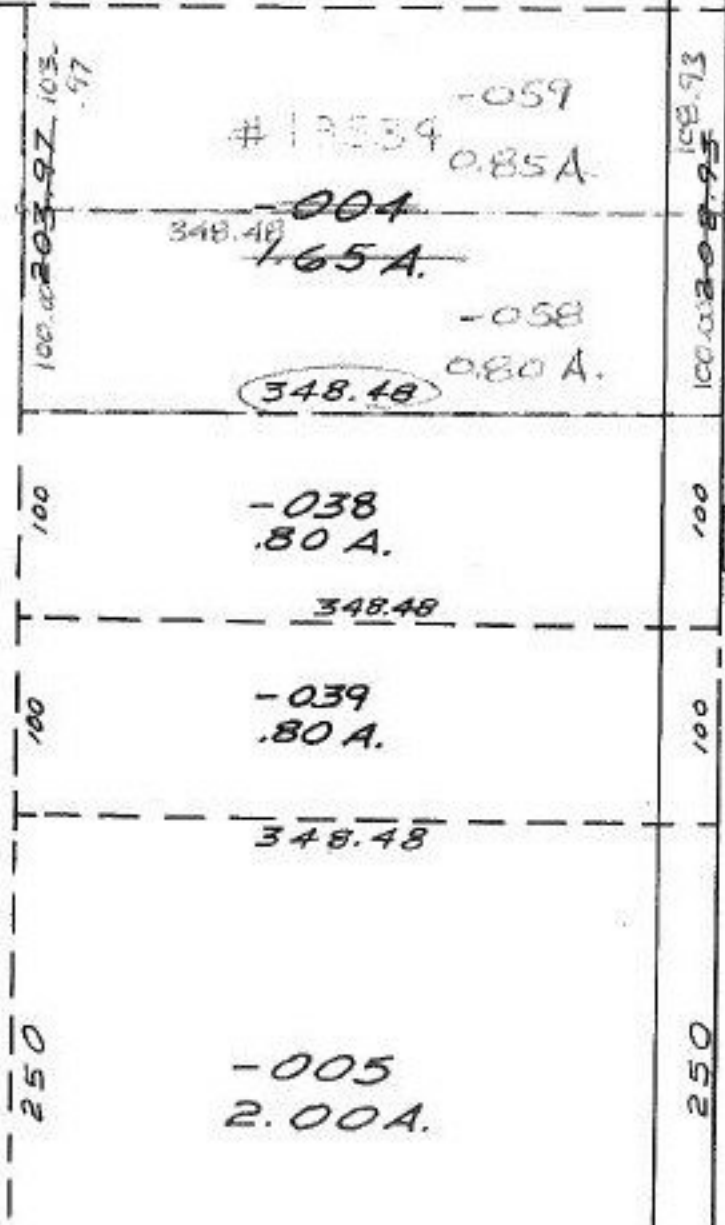

# 18534  
-059  
0.85 A.

~~004~~  
348.48  
~~1.65 A.~~  
-058  
0.80 A.

-038  
80 A.  
348.48

-039  
80 A.  
348.48

-005  
2.00 A.

83

8/4/89  
#18534

11-00-046-A  
APPROVED  
LORAIN CO.  
MAP DEPT.  
DATE 7-20-89  
PAGE 11-00-055-B  
BY T. W. *Wain*  
VOID AFTER 18534