


-016
B.61A.

.60

026-B

SEE SURVEY MAP BY
M. G. HORA
CL. 1: 1,000, 000
PRIOR INST REF - 684/513

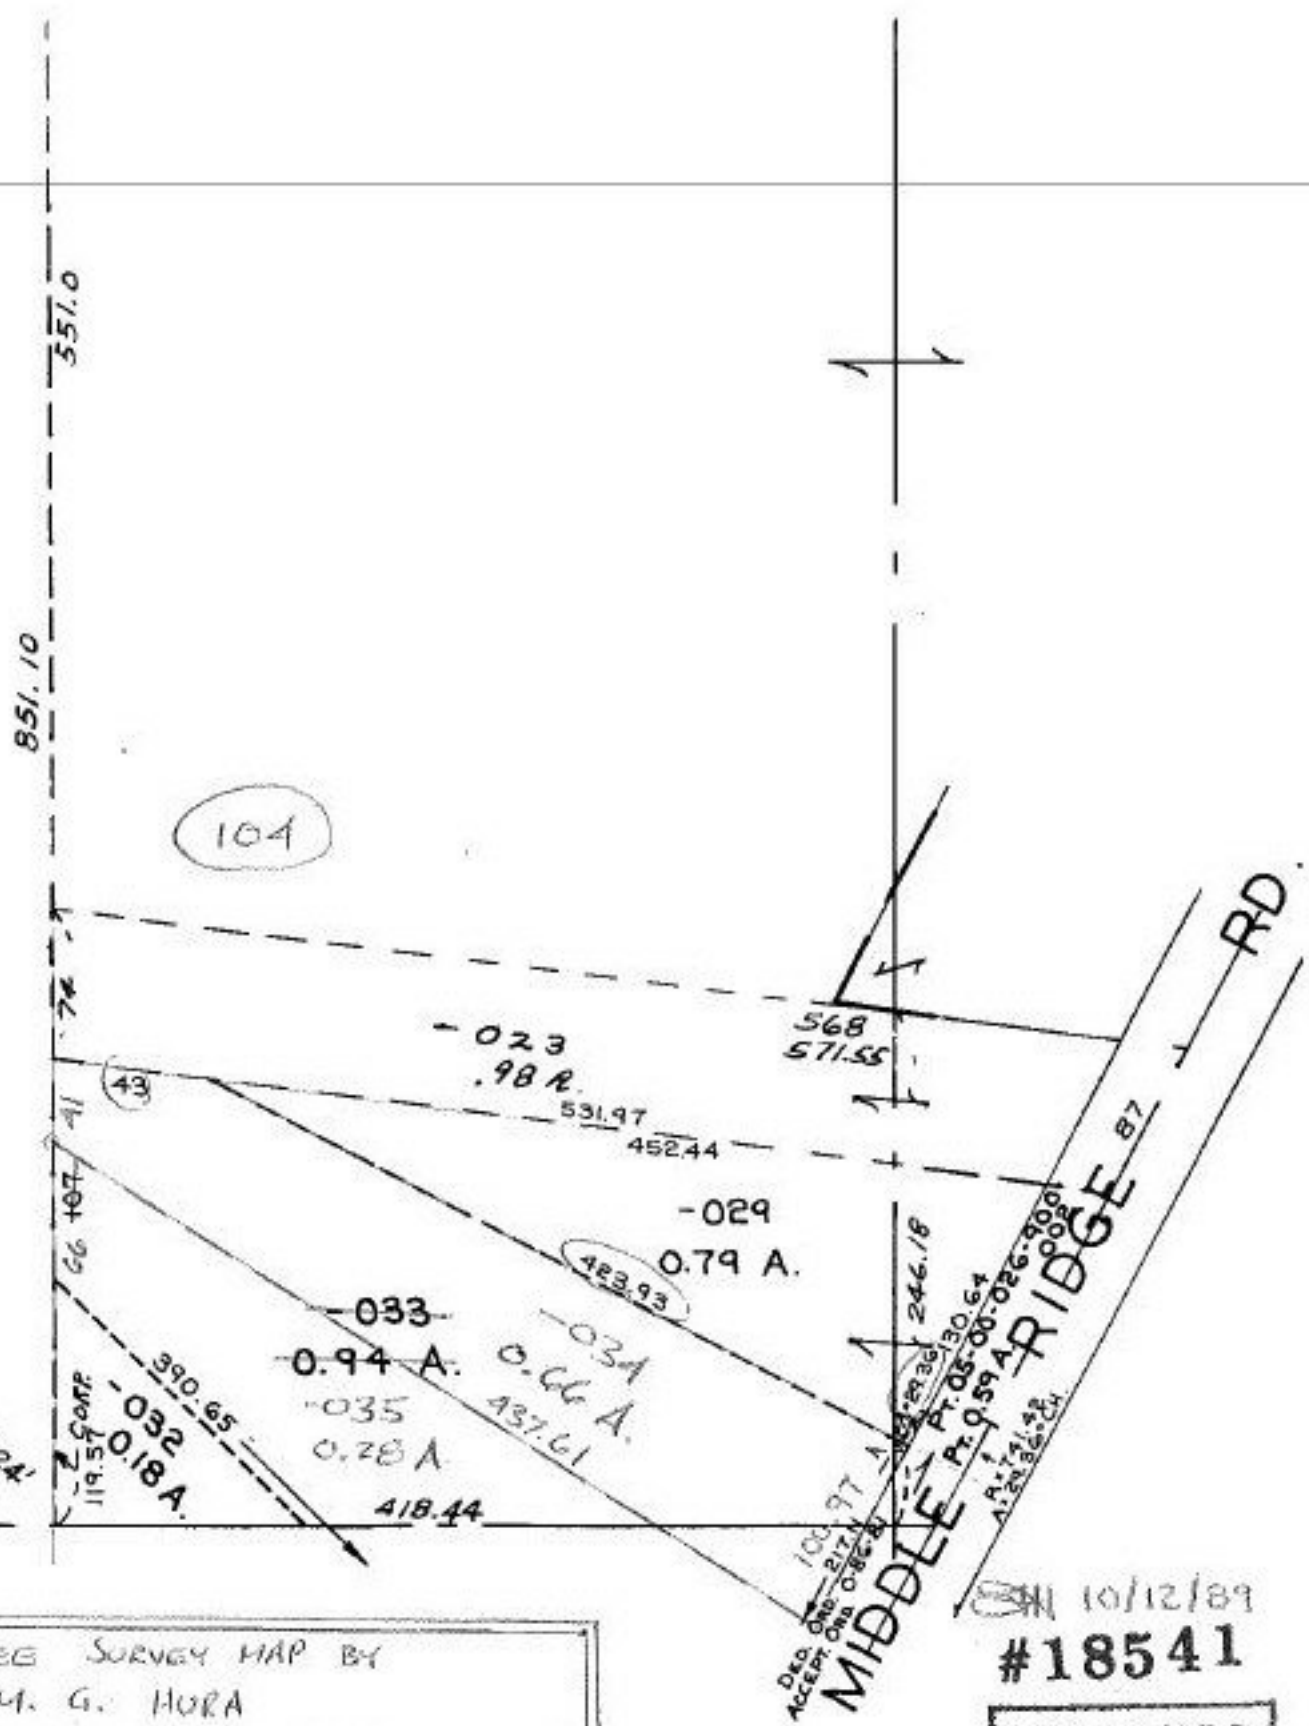

10/12/89
#18541

APPROVED
LORAIN CO.
MAP DEPT.
DATE 7-21-89
PAGE 5-00-025-B
BY T. Mearns
VOID AFTER 18541