

T. MAP & SURVEY INFORMATION - CALG.

-077 3.51
 SPAC 1.98
 REM 1.53

Survey
 N. LINE PARCEL (1) 300.12
 (2) 289.94
 590.06
 TAX MAP 589.79

Survey
 S. LINE PARCEL (1) 309.93
 (2) 299.46
 609.39


L. LINE
 Survey (1) 222.45
 Parcel (2) 31.00
 253.44
 Survey (2) 155.31
 Parcel (4) 27.99
 183.30
 T. MAP 186.30

DIFFER 0.27
 N. LINE PARCEL (3) 309.93
 (4) 299.46
 609.39

(3) 298.43
 (4) 311.00
 609.43
 298.43
 11.54
 309.97

TAX MAP 95+234.43+280
 = 609.43

SEE 4-00-023-D

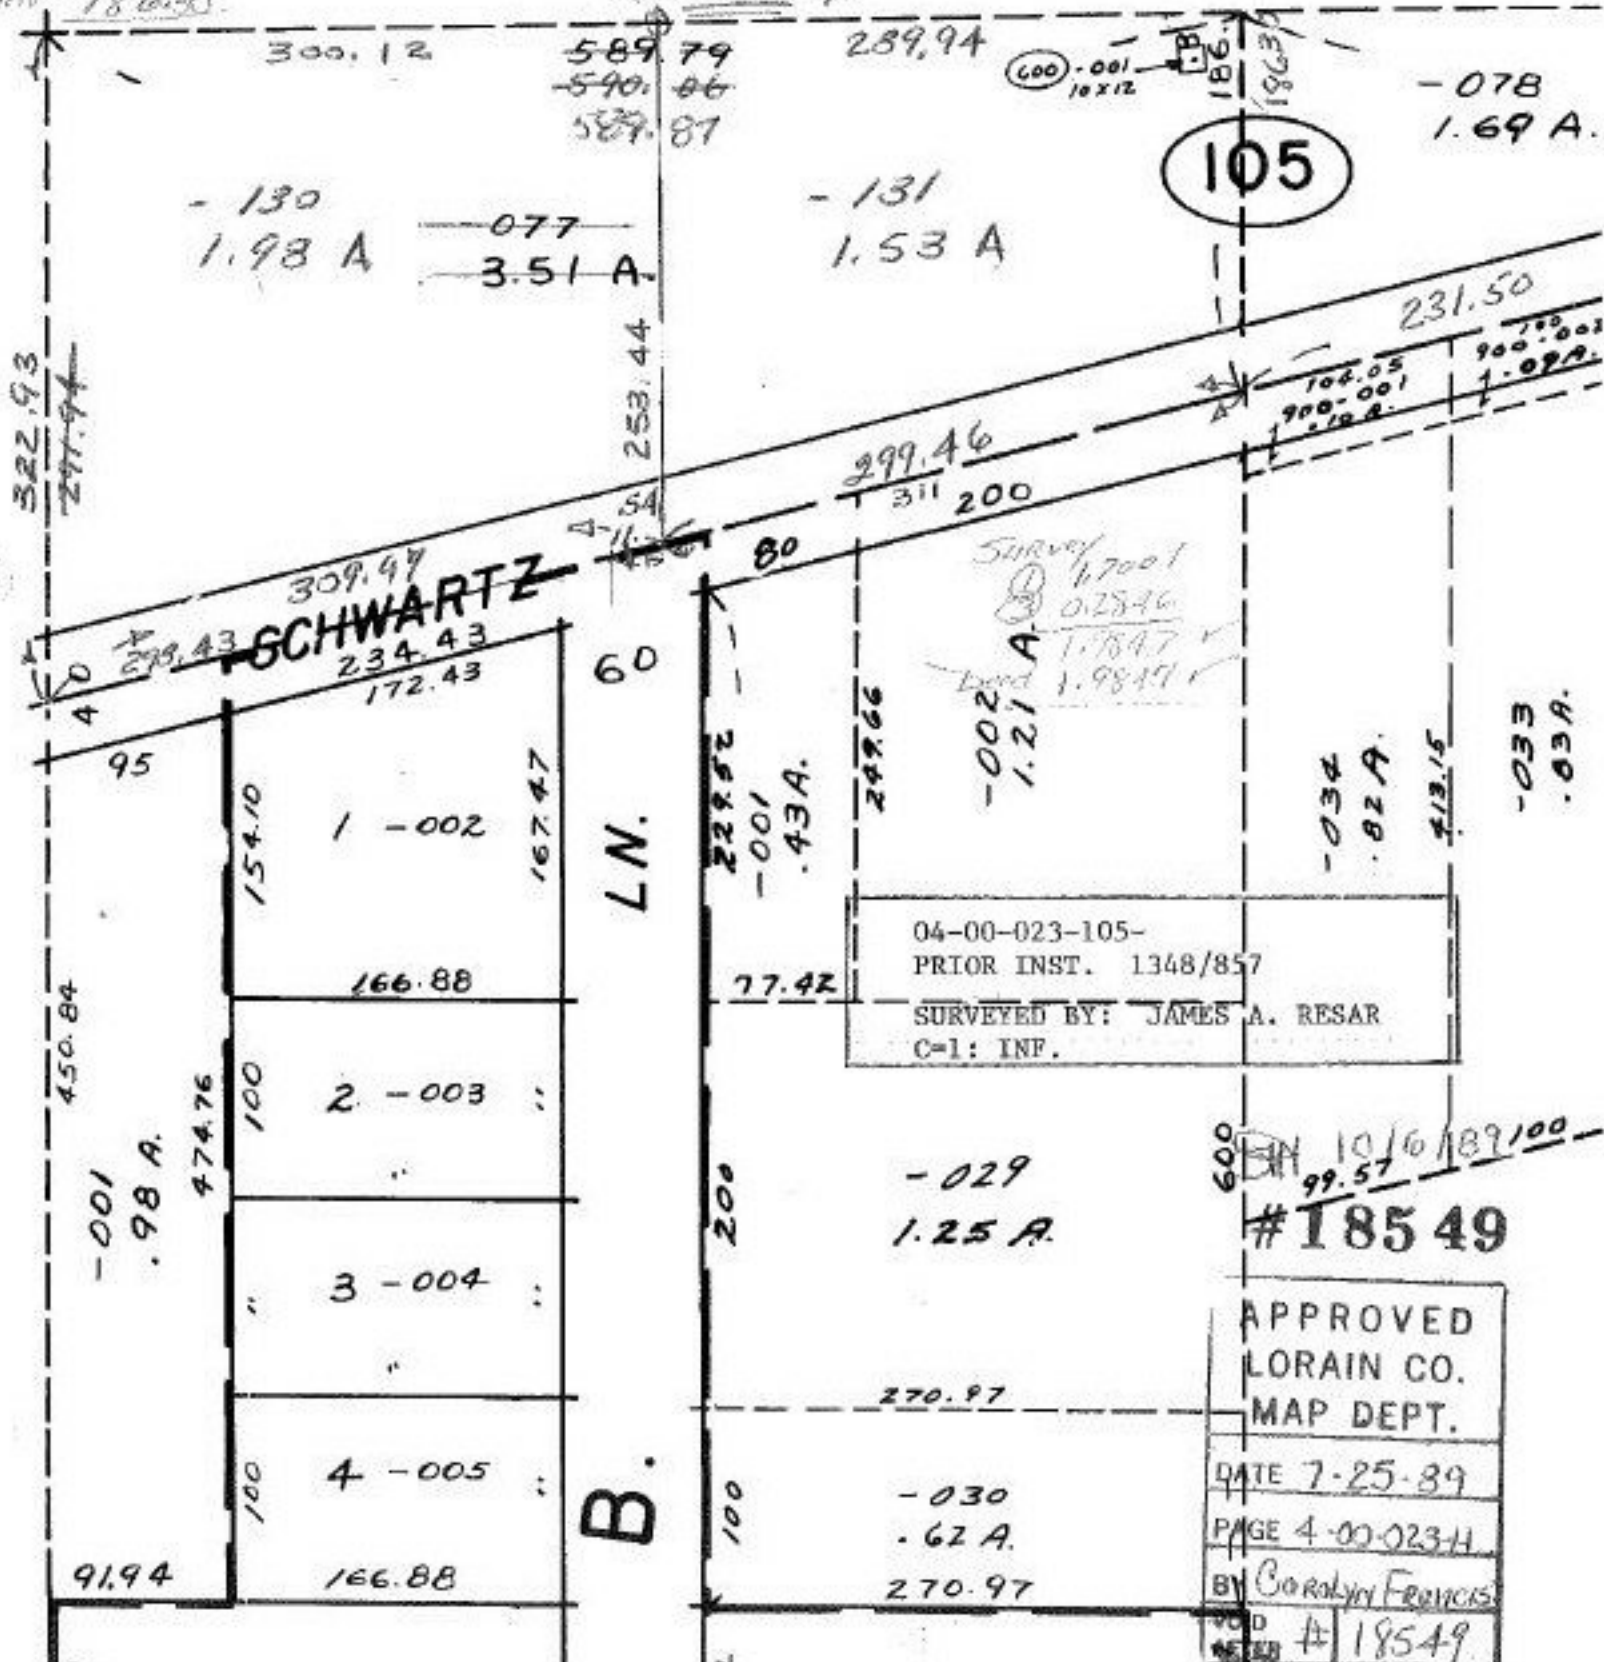

04-00-023-105-
 PRIOR INST. 1348/857
 SURVEYED BY: JAMES A. RESAR
 C=1: INF.

10/6/89/100
 99.57
 #18549

APPROVED
 LORAIN CO.
 MAP DEPT.
 DATE 7-25-89
 PAGE 4-00-023-H
 BY Carolyn Francis
 #18549