


PLOT PLAN (NOT A SURVEY) BY
 PAT MCCANNON
 CL. L.I.N.F.

PROR @ @
 INST. REF. 1217/520 1034/464

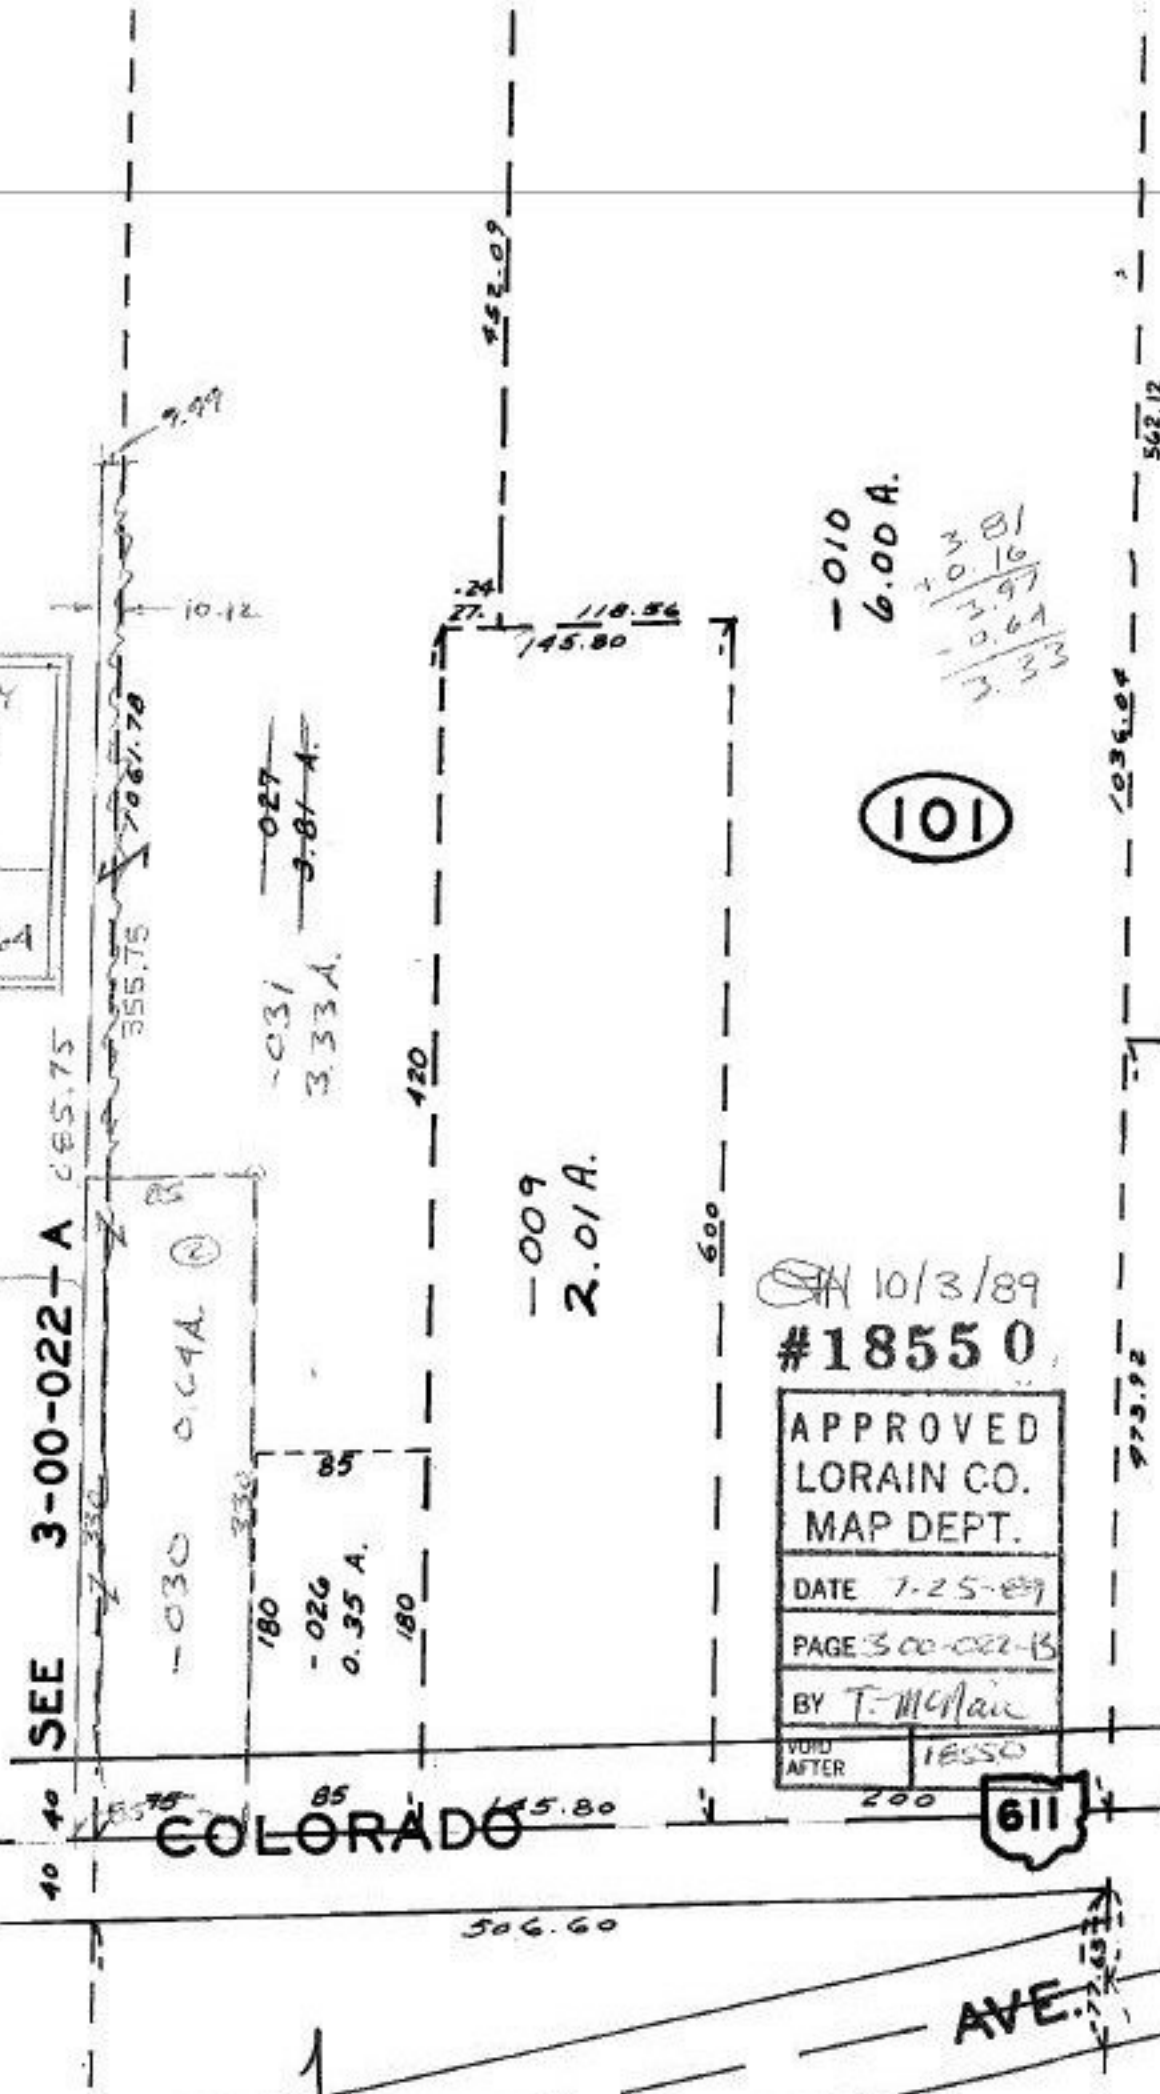

10/3/89
 #18550
 APPROVED
 LORAIN CO.
 MAP DEPT.
 DATE 7-25-89
 PAGE 300-022-13
 BY T. McMane
 VOID AFTER 18550

0.381
 2.97
 - 0.64
 3.33

101

611

COLORADO

AVE.