


42.64 A. - D

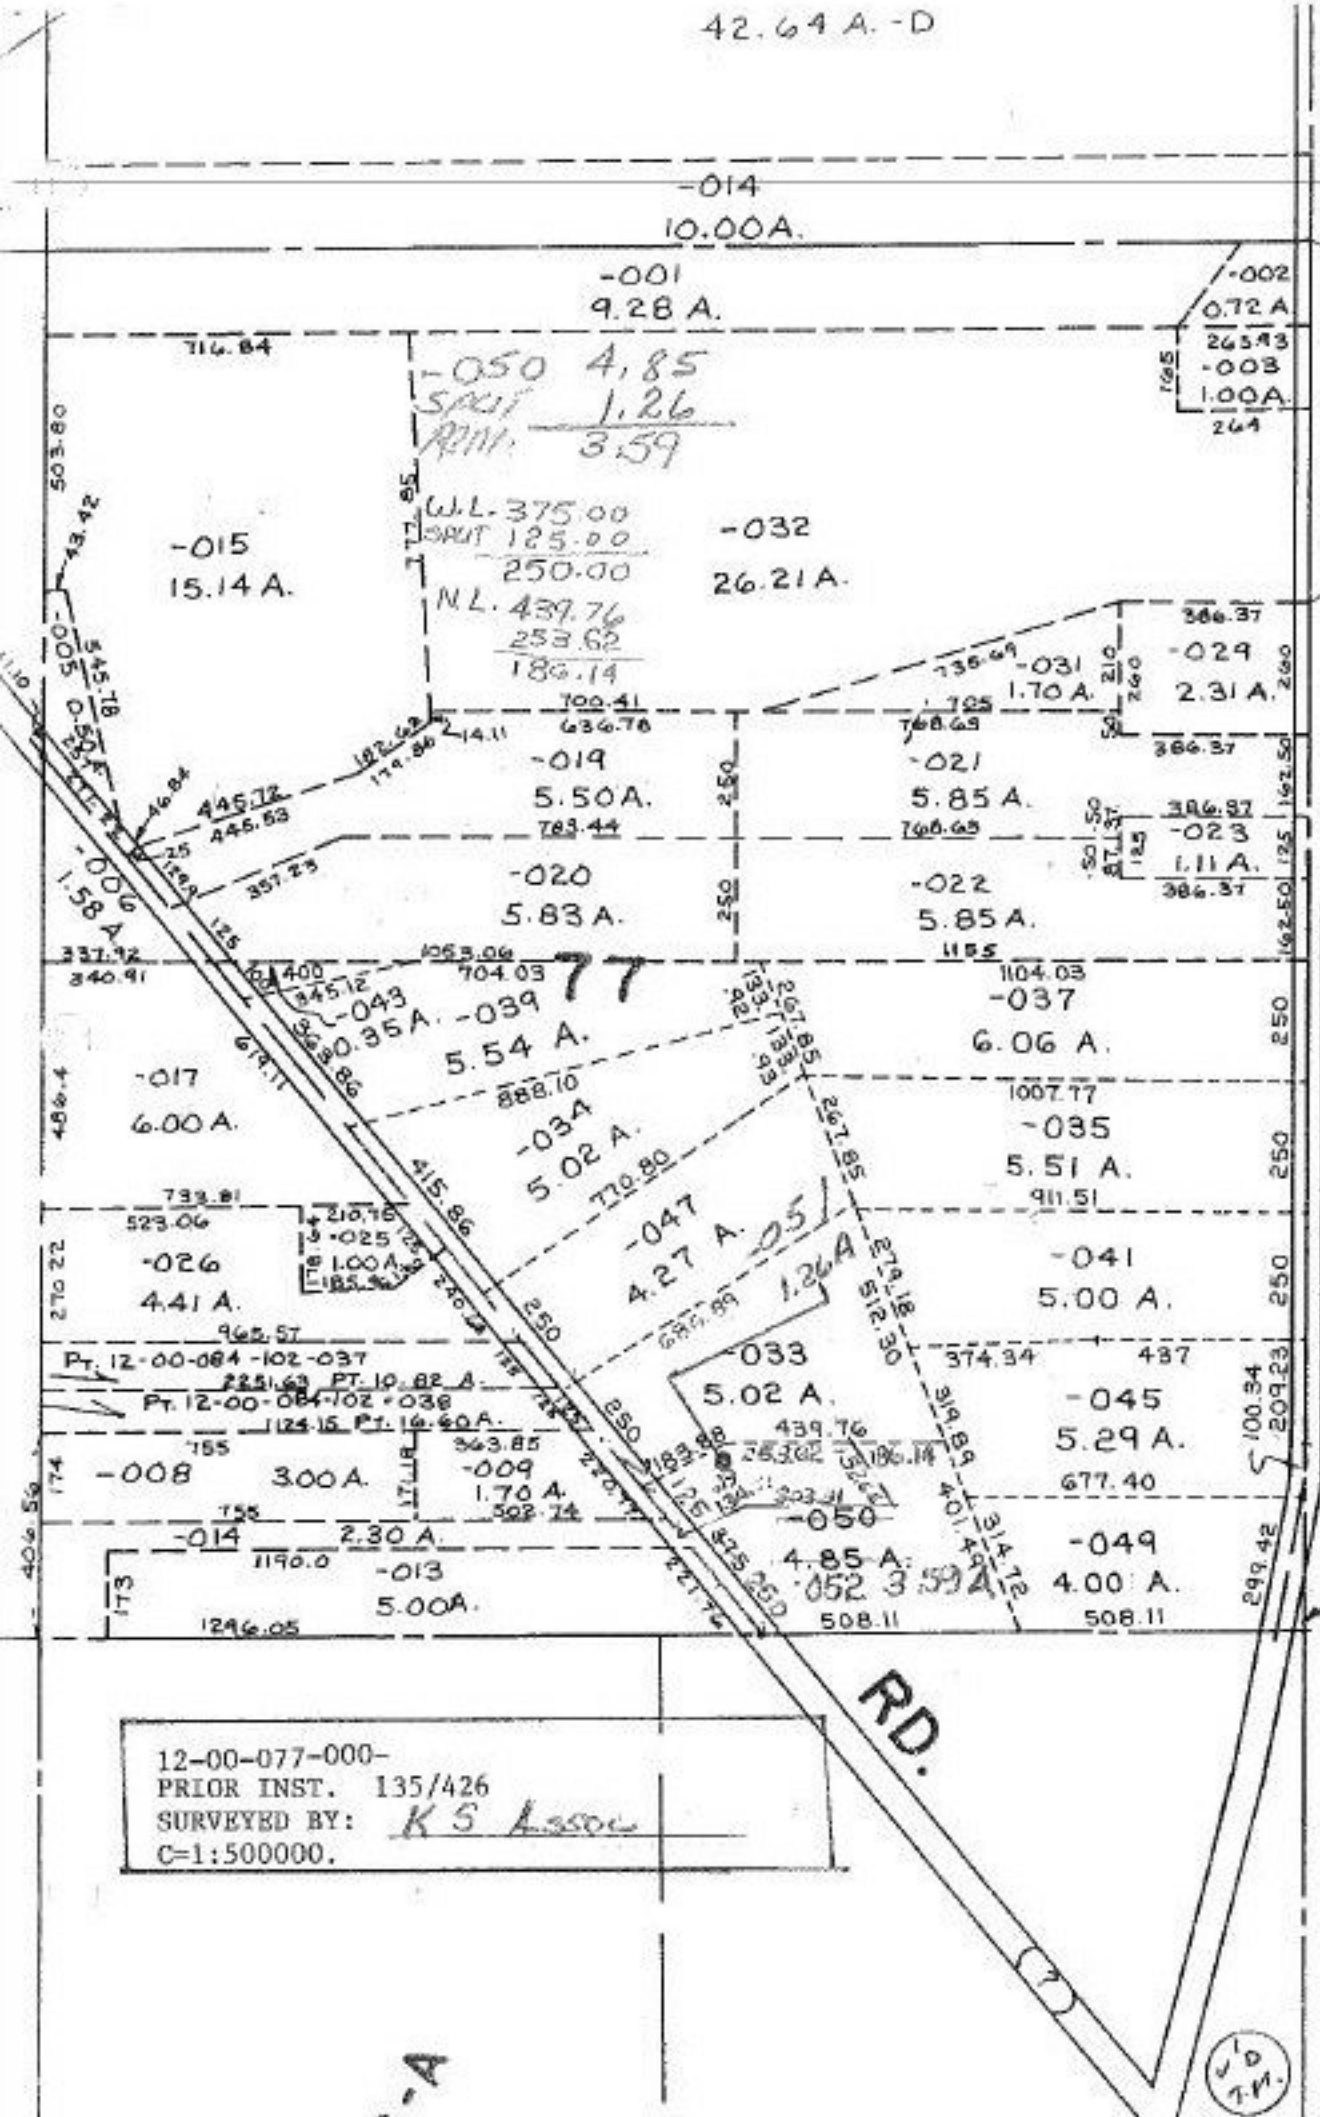

745.47

OCT 25 1989
10-25-89

#18564

APPROVED
LORAIN CO.
MAP DEPT.

DATE 8-7-89

PAGE 12-A

BY FRANCIS

VOID AFTER # 18564

10
T.M.