


9

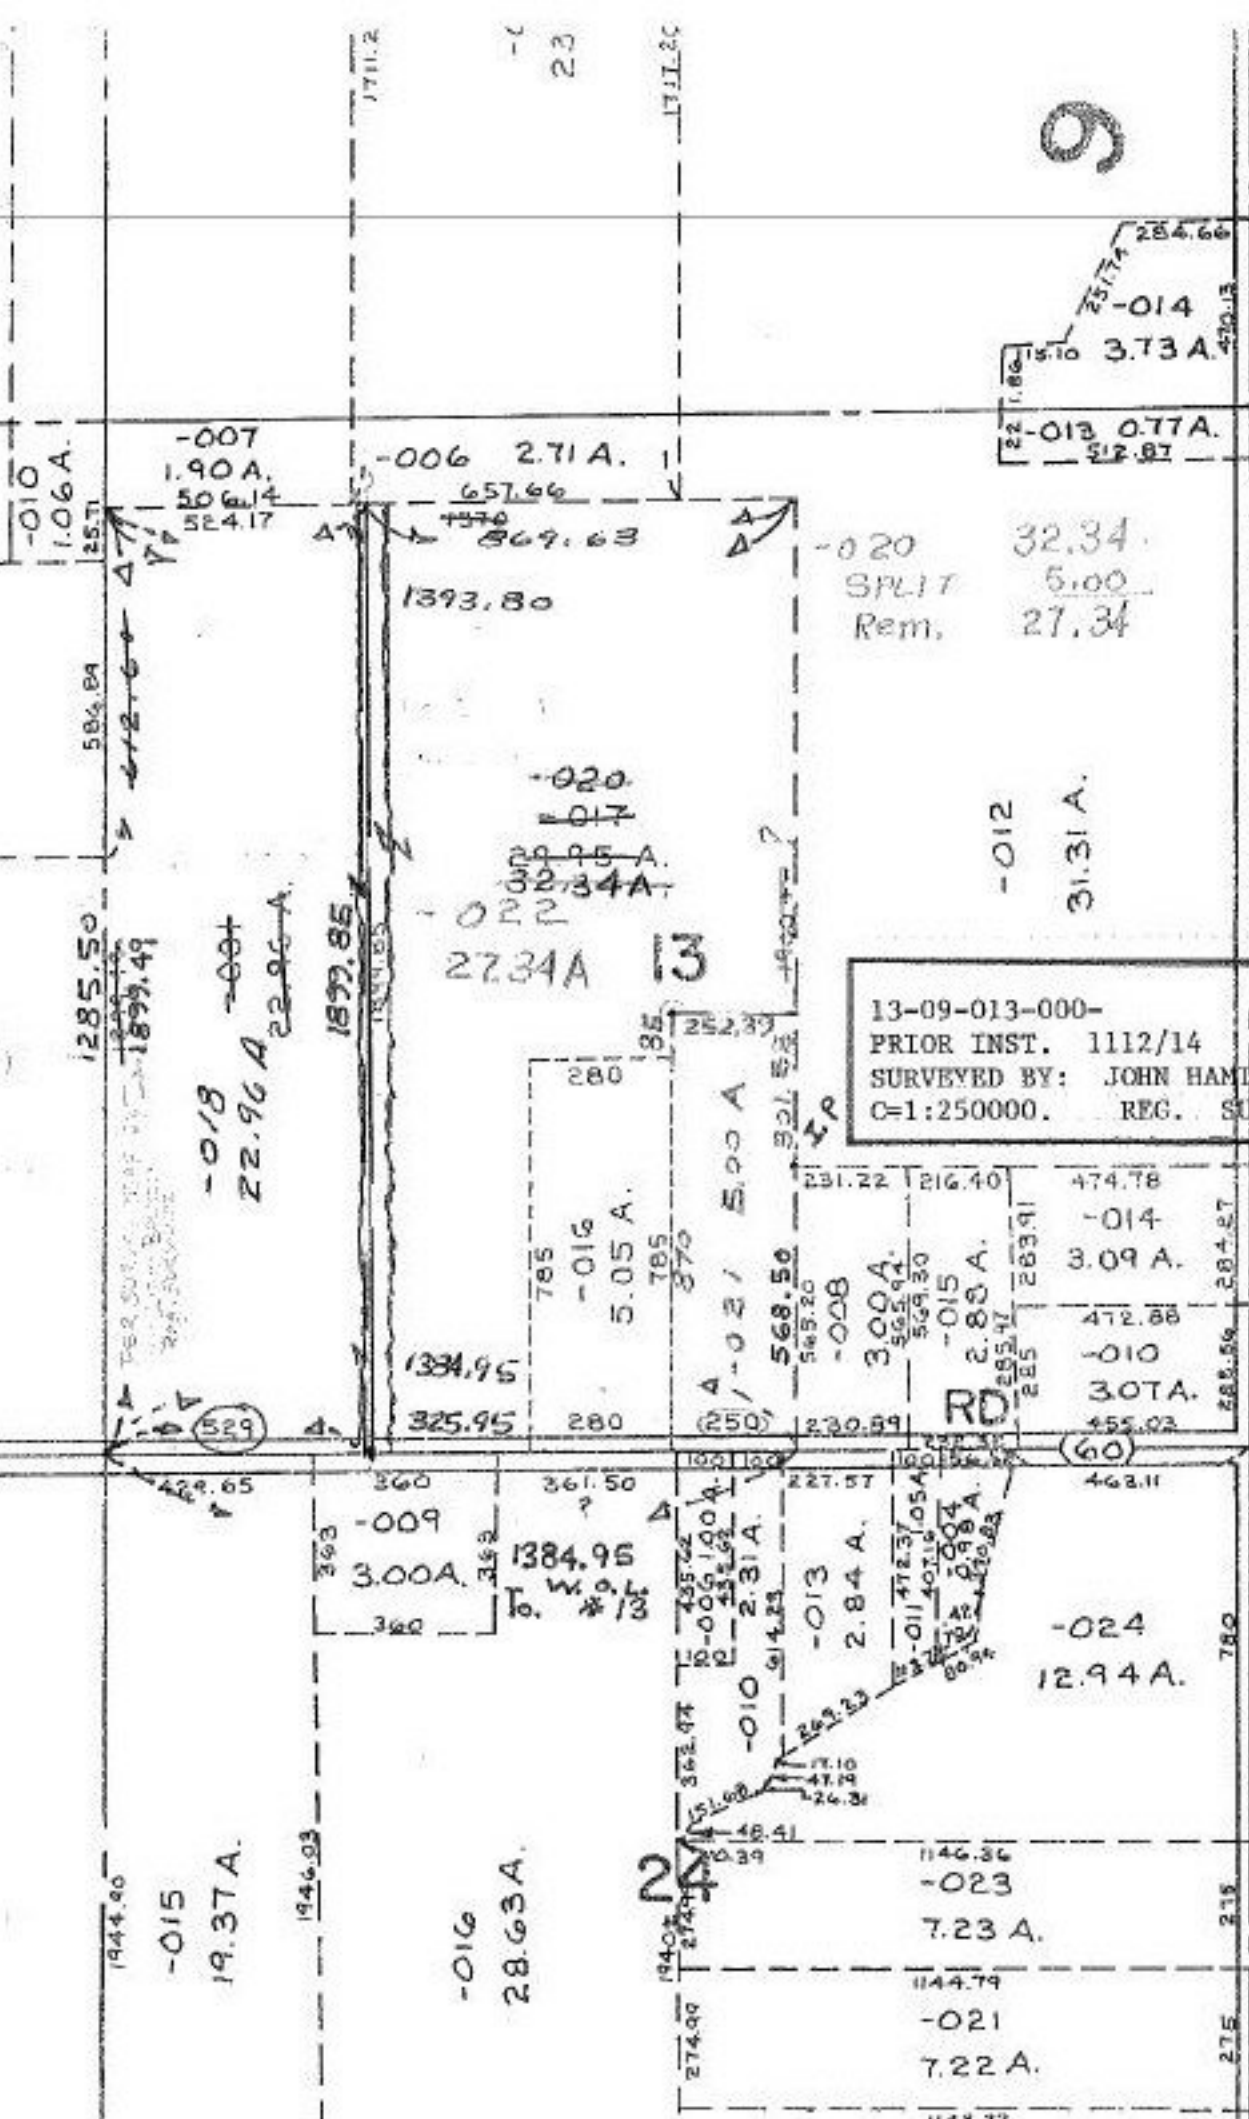

13-09-013-000-  
 PRIOR INST. 1112/14  
 SURVEYED BY: JOHN HAMILTON  
 C=1:250000. REG. SURVEYOR

10/31/89  
 #18579

APPROVED  
 LORAIN CO.  
 MAP DEPT.  
 DATE 3-14-89  
 PAGE 13-G  
 BY CAROLYN  
 FRANCIS  
 9010  
 8788 X 18579