


GGS RD.
CENTER LINE

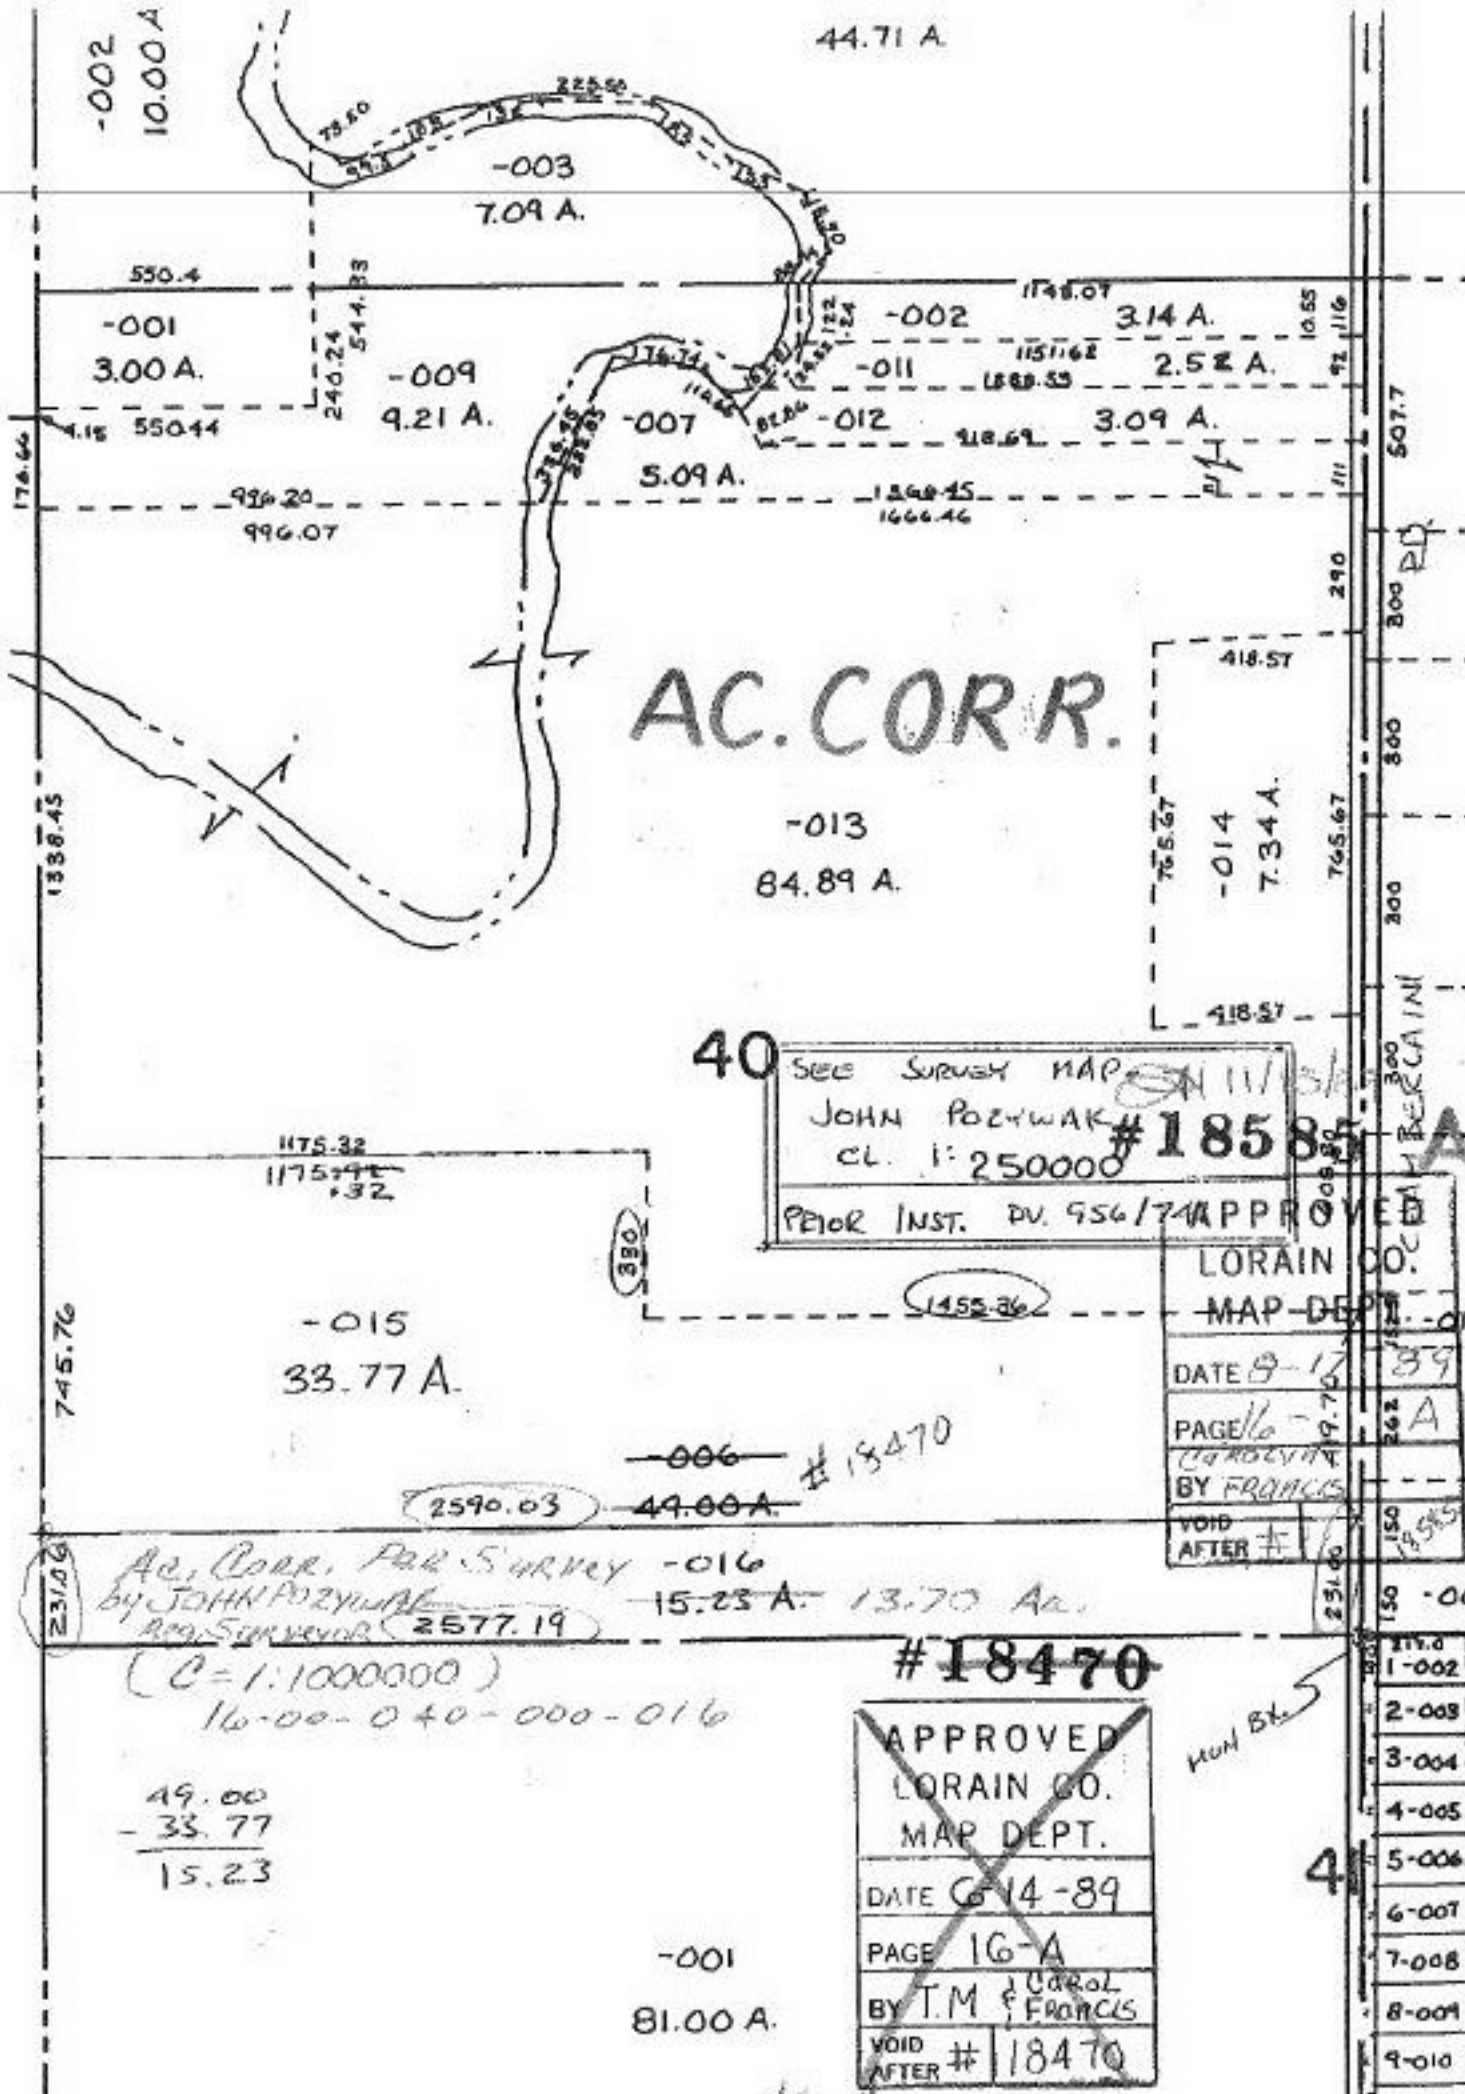

AC CORR.

40 SEE SURVEY MAP
 JOHN POZYWAK #18585
 CL. 1:250000
 PRIOR INST. DV. 956/74 APPROVED

LORAIN CO. MAP DEPT.	
DATE 8-17-89	39
PAGE 16-A	262
CORRECTED BY FRANCIS	150
VOID AFTER #	150

Ac. Corr. Par. Survey -016
 by JOHN POZYWAK
 Reg. Surveyor #2577.19
 15.23 A. 13.70 A.

(C=1:1000000)
 16-00-040-000-016

49.00
 - 33.77
 15.23

#18470
~~APPROVED~~
~~LORAIN CO.~~
~~MAP DEPT.~~
 DATE 6-14-89
 PAGE 16-A
 BY T.M. & CAROL FRANCIS
 VOID AFTER #18470

Map Bk.

1-002
2-003
3-004
4-005
5-006
6-007
7-008
8-009
9-010
10-011

-001
 81.00 A.

16 A