

2.505
2.11
2.11

15-00-063-000- PRIOR INST. OR. 206/440
SURVEYED BY: JOHN POZYWAK REG. SURVEYOR
C=1: INF.

-024
30.42 A.

-029
20.25 A.

957.05
-018
6.04 A.
956.30

-001
9.58 A.
1688.02

-002
6.00 A.

027 70.812
SPLIT 5.22
Rem 65.59 A
Rem 65.59

-003
50.57 A. Dup.
50.75 A. Map.

EAST LINE
1309.27
400.00
909.27

2128 WEST LINE
28.76
139.19
367.95


496
514.62

EAST LINE
400.00
200.00
200.00
N. LINE
339.19
200.00
139.19

63
-032
-027
70.81 A.
65.59 A

-031
5.22
2.72
2.50

APPROVED
LORAIN CO.
MAP DEPT.
DATE 8-21-89
PAGE 15-E
BY CAROLYN FRANKS
VOID 18593

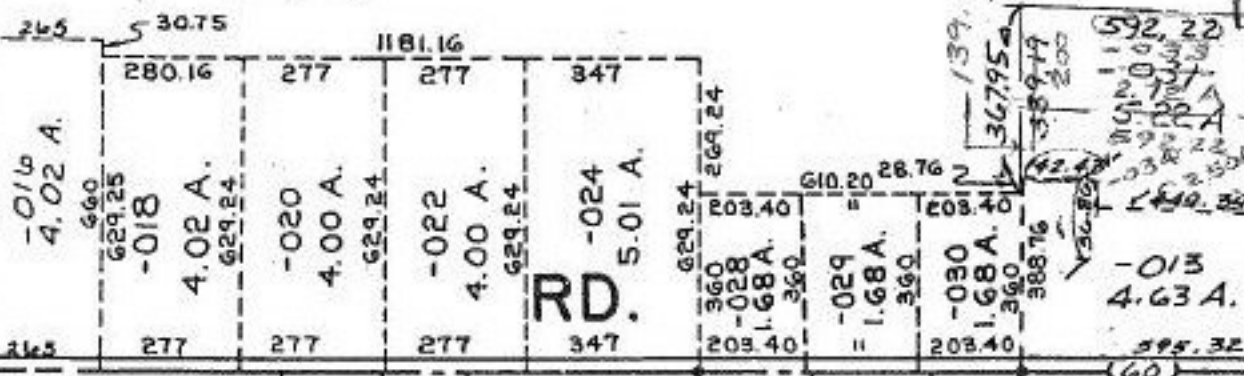

15-00-063-000-
PRIOR INST. 1259/791
1348/722
SURVEYED BY: JOHN POZYWAK
C=1: 111,111. REG. SURVEYOR

#18556
APPROVED
LORAIN CO.
MAP DEPT.
DATE 8-3-89
PAGE 15-E
BY CAROLYN FRANKS
VOID 18556

Mon
130x

18593

R.P.S.

91.35