


LD 225 200 576 RD. (60?) 303

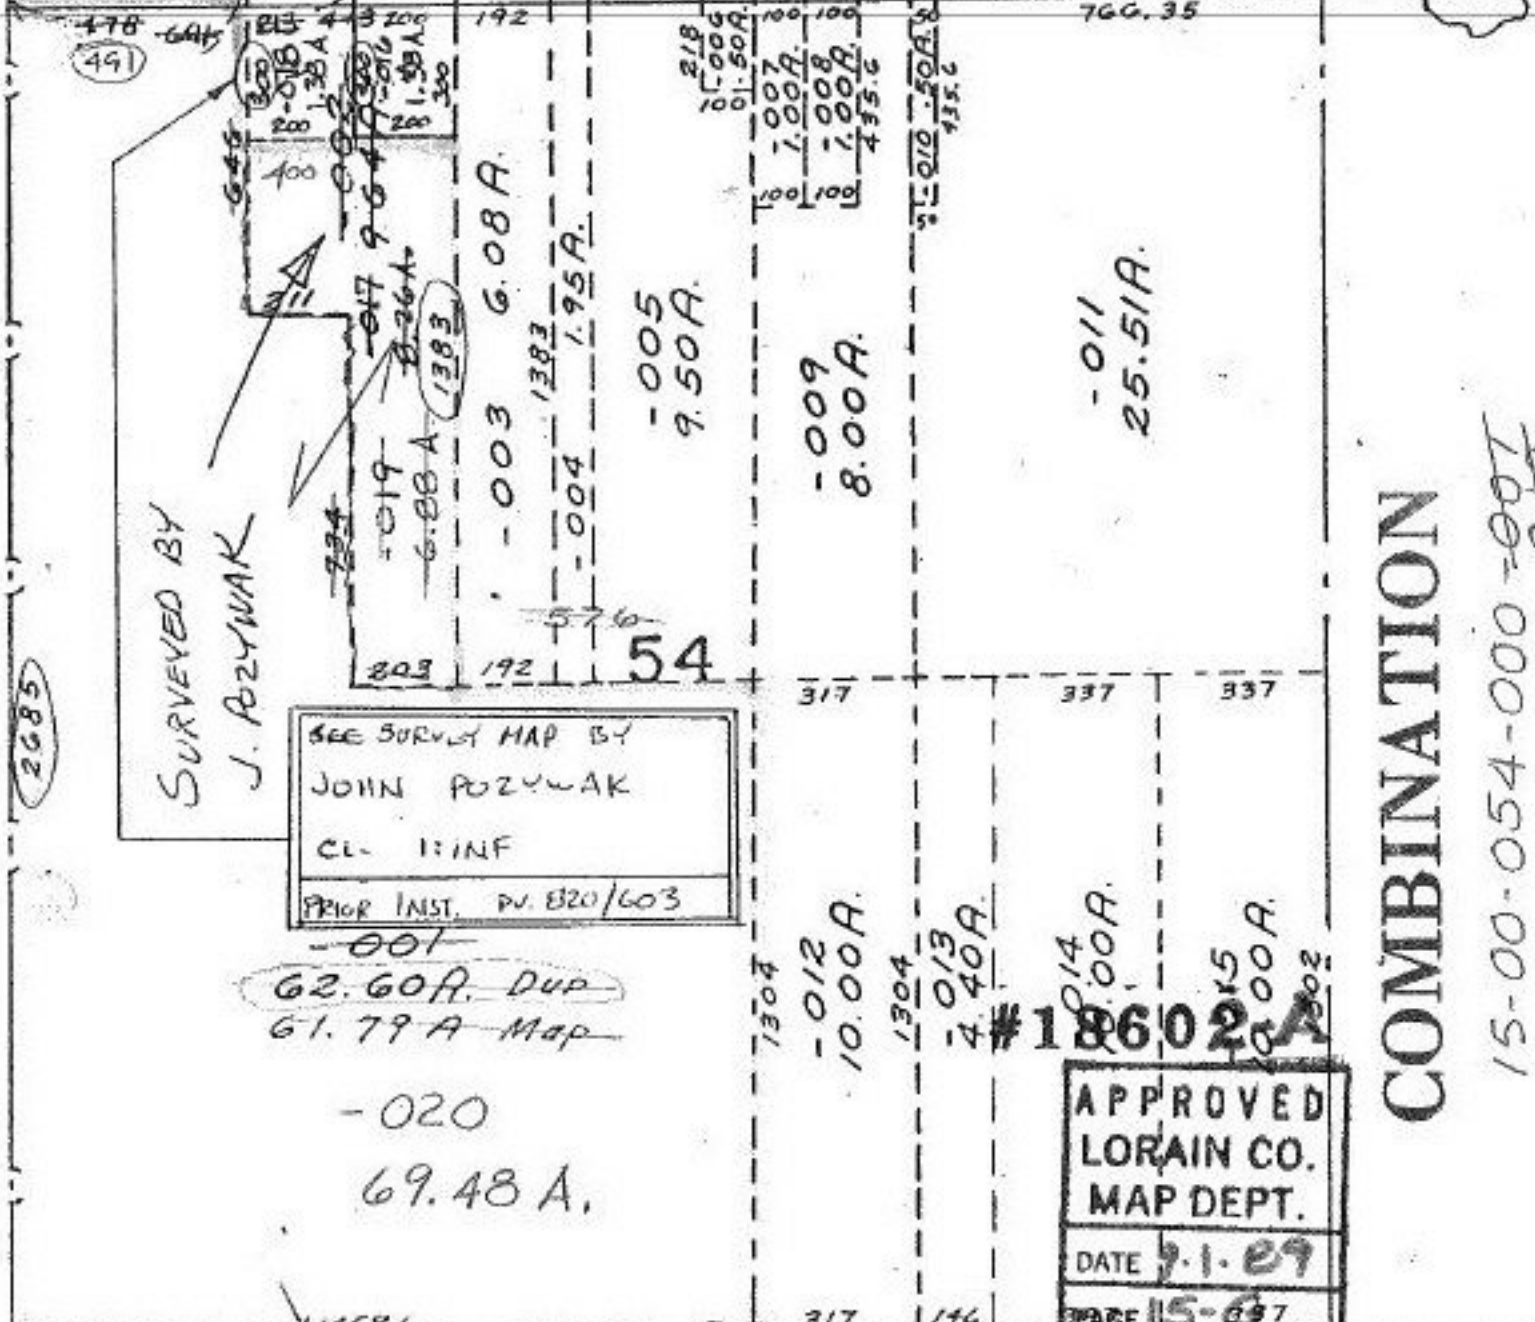

SURVEYED BY J. POZYWAK

SEE SURVEY MAP BY JOHN POZYWAK CL. 1:1 INF PRIOR INST. PV. E320/603

COMBINATION

15-00-054-000-007 019

62.60A. Dup  
61.79A Map

69.48 A.

APPROVED  
LORAIN CO.  
MAP DEPT.  
DATE 7-1-87  
PAGE 15-67  
BY C.E. FRANCIS  
VOID AFTER 18602

#15383  
APPROVED  
LORAIN CO.  
MAP DEPT.

APPROVED  
LORAIN CO.  
MAP DEPT.  
DATE 8-11-87  
PAGE 15-6  
BY T. M. Laix  
VOID AFTER 18577

DATE 12-2-83  
PAGE 15-6  
BY T. M. Laix  
VOID AFTER

MAP  
61.79  
6.88  
62.60 Ac.  
Dup. & Reg.  
62.60 Ac.  
6.88 Ac.  
69.48 Ac.

The 62.60 Ac.  
CARRIED IN REG  
TAX MAP OFFICE  
USING THE 62.60

667 AC. UNTIL OTHER  
INFORMATION  
IS AVAILABLE

928.25  
-001  
-019  
-001  
-019

165.10 90.05 671.38 585.59 1768.6 585.58 483