


SEE I-C

DR. C

PLAT VOL. 10 PG. 26

HELEN

K.S. SURVEY
DISAGREES
W/ A. KOEPP
SURVEY TIME
CREATED
-003
-005

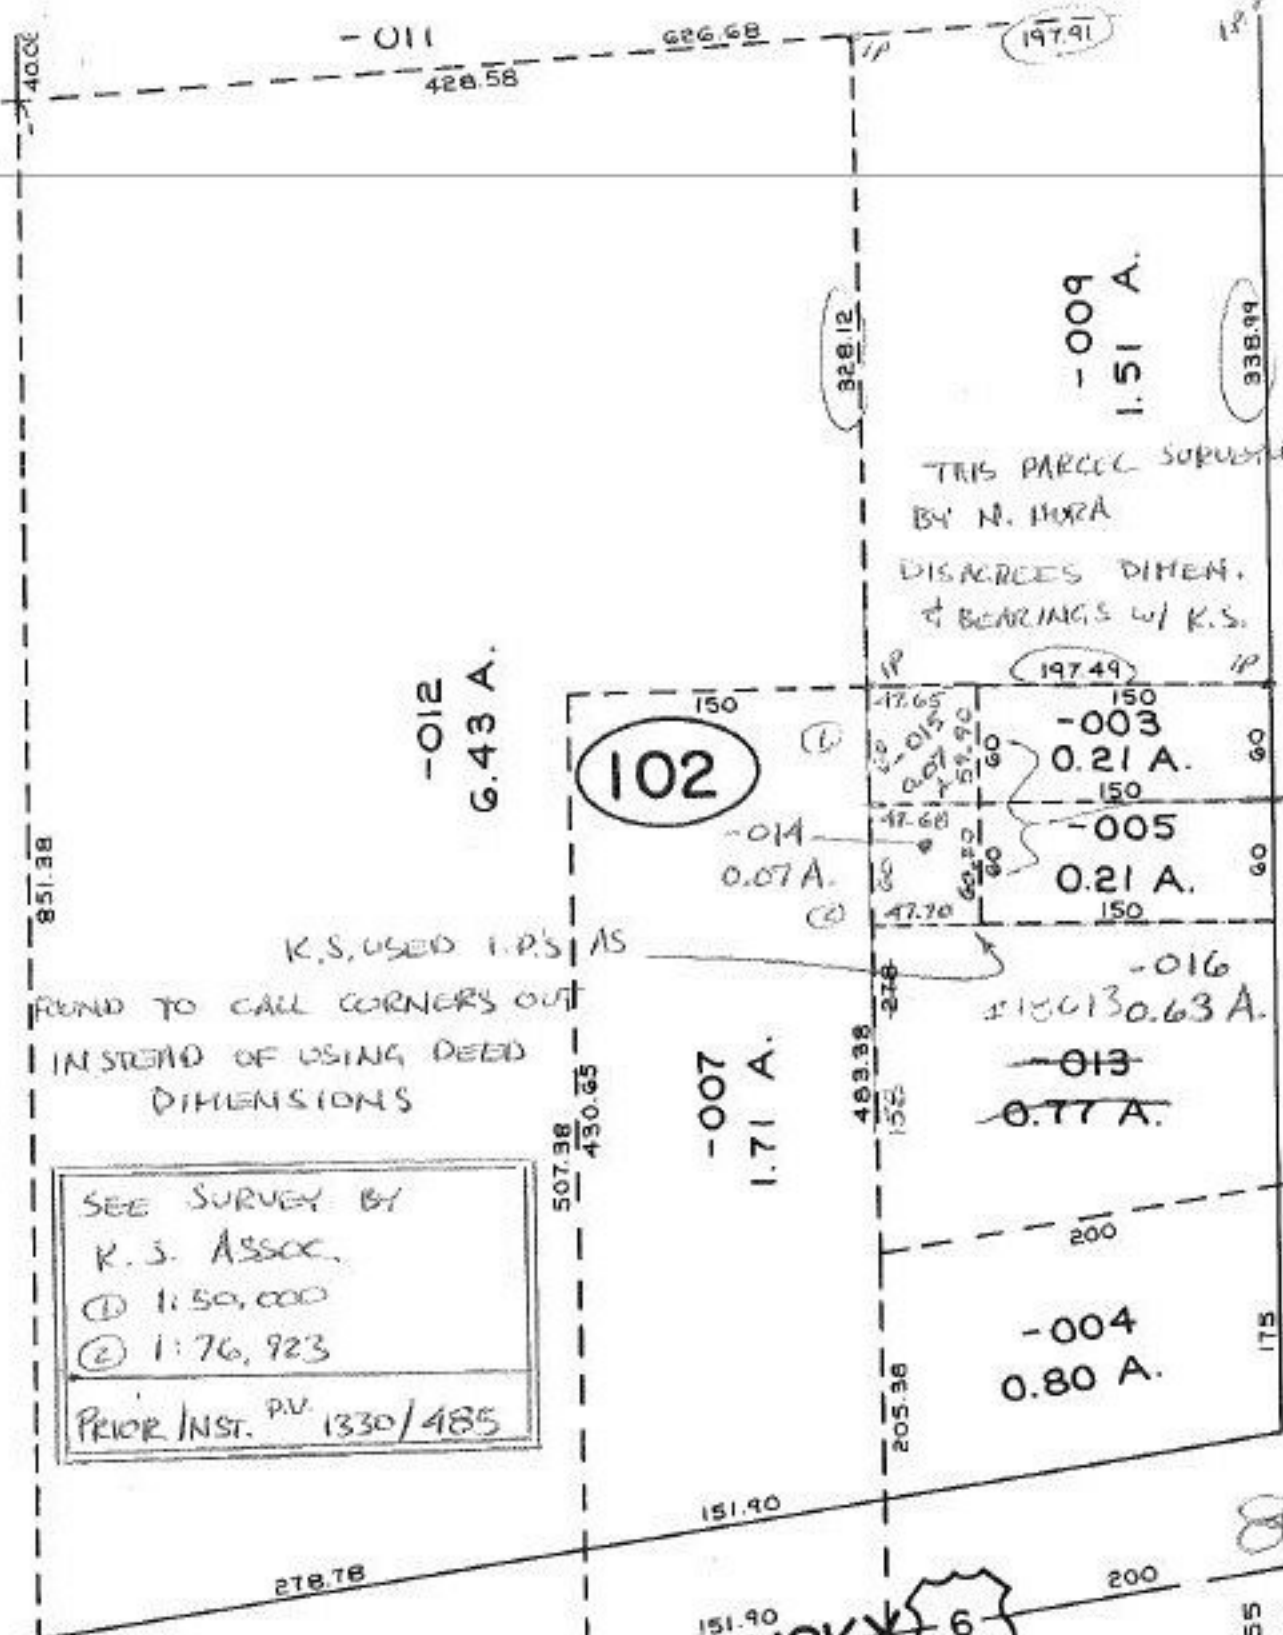

SEE SURVEY BY
K.S. ASSOC.
① 1:50,000
② 1:76,923
PRIOR INST. P.V. 1330/485

K.S. USED I.P.S. AS
FOUND TO CALL CORNERS OUT
INSTEAD OF USING DEED
DIMENSIONS

THIS PARCEL SURVEYED
BY N. MORA
DISAGREES DIMEN.
& BEARINGS W/ K.S.

APPROVED
LORAIN CO.
MAP DEPT.
DATE 11-2-89
PAGE 1-00-005-B
BY T. McMain
VOID AFTER 18613

55 50 18613 1998
189.82 283.68

CLEVELAND SANDUSKY 6

-130