

492.29 TAX MAP  
442.28 SURVEY  
01 Differ

06-24-043-101- & 06-24-048-000-  
SURVEYED BY: MICHAEL G. HURA REG. SURV.  
PRIOR INST. 1314/763 (1) (3) (4) C=1:1000000.  
(2) C=1:500000.


WRST. LINE  
120.01  
132.25  
120.01  
120.01  
492.28

- 012  
4.20  
1.13  
3.07  
4.02  
2.05  
1.02  
1.03

O.L. 48  
18.73  
-5.03  
13.70  
4.56  
9.14  
4.57  
4.57

- 009  
18.73  
-5.03  
13.70  
4.56  
9.14  
4.57  
4.57

O.L. 43  
SPUT ①  
SPUT ②  
SPUT ③  
REM ④

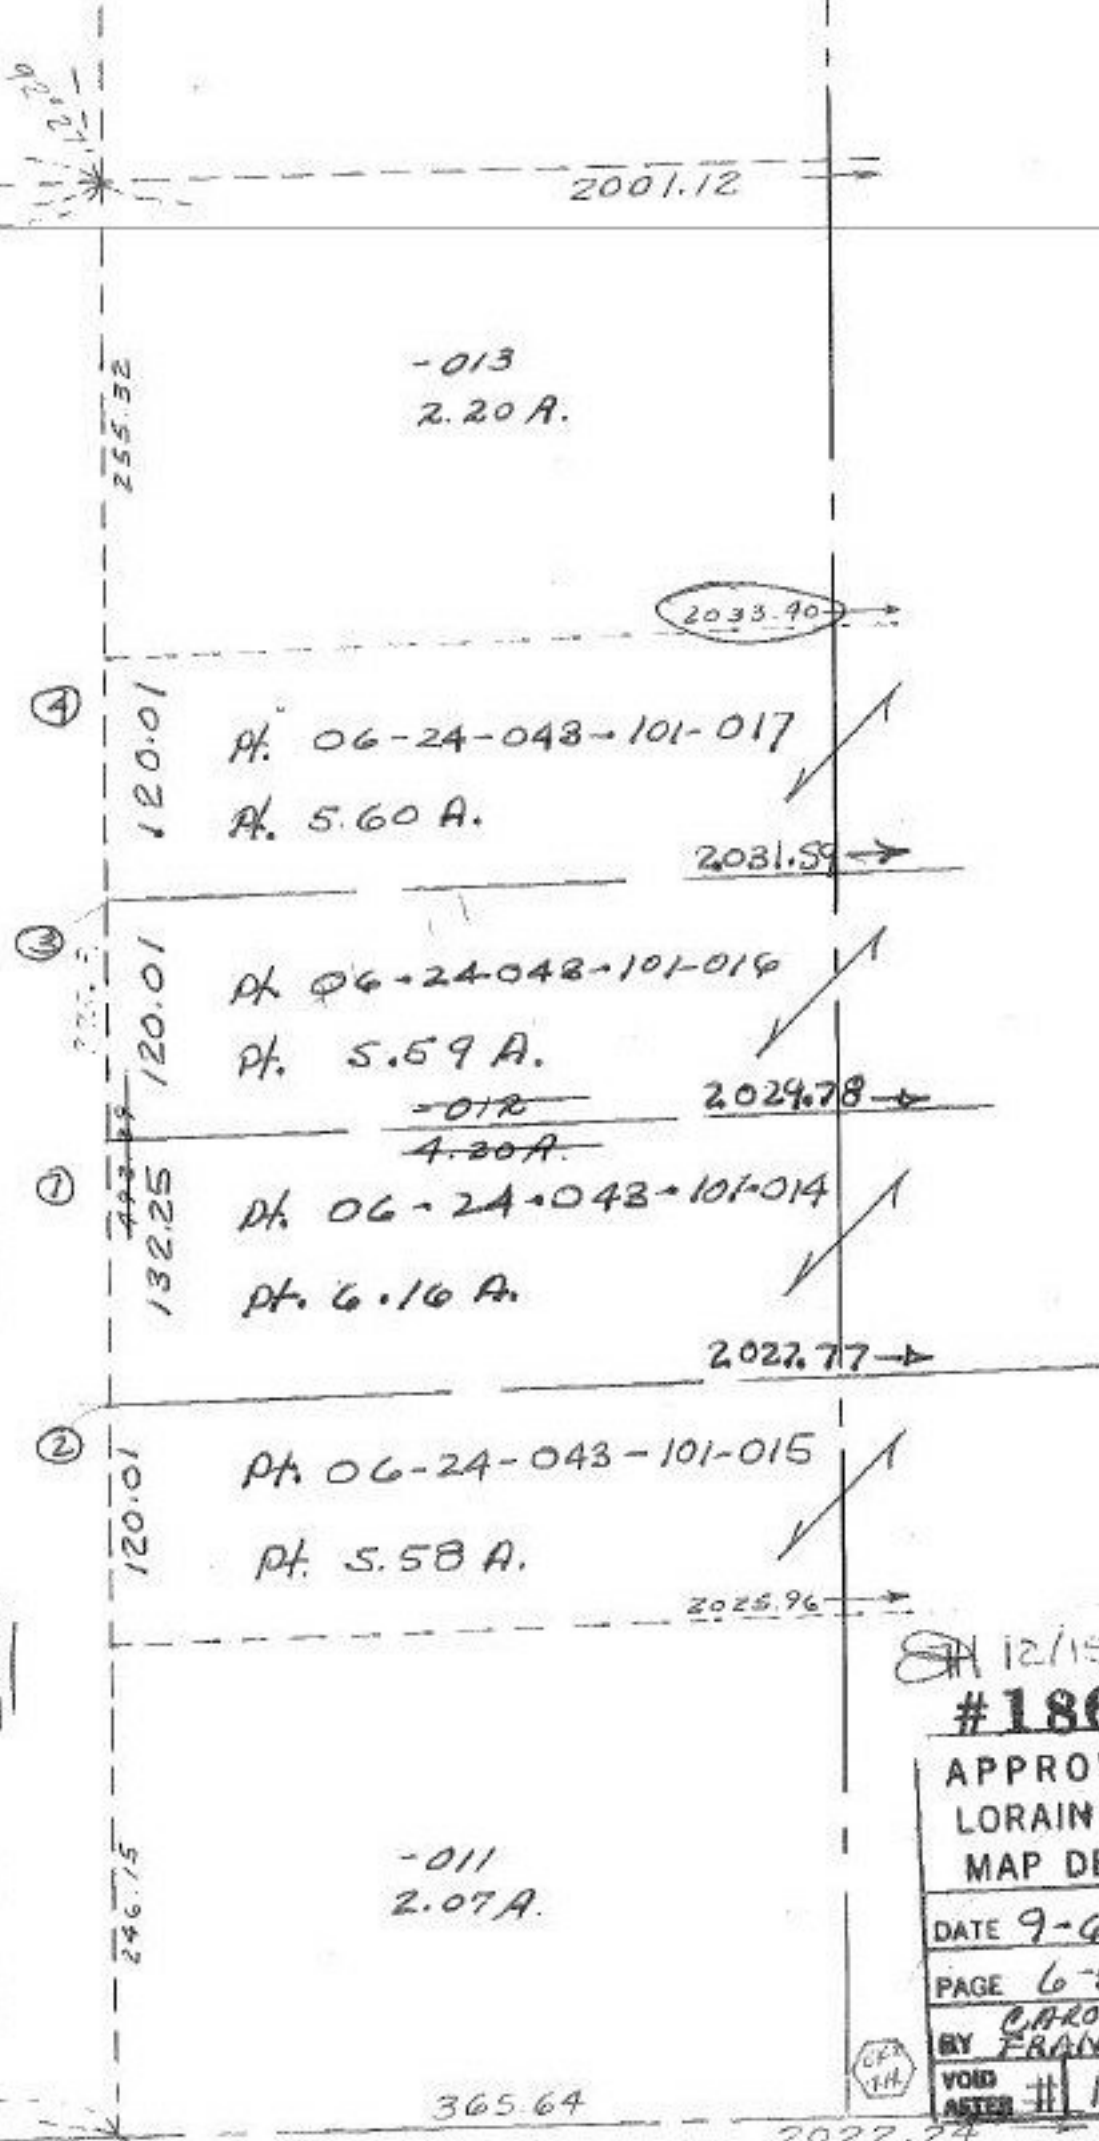

- 013  
2.20 A.

2033.90

④

Pt. 06-24-043-101-017  
Pt. 5.60 A.

2031.59

③

Pt. 06-24-043-101-016  
Pt. 5.59 A.

2029.78

- 012  
4.20 A.

①

Pt. 06-24-043-101-014  
Pt. 6.16 A.

2022.77

②

Pt. 06-24-043-101-015  
Pt. 5.58 A.

2025.96

- 011  
2.07 A.

12/15/89  
#18614

APPROVED  
LORAIN CO.  
MAP DEPT.  
DATE 9-6-89  
PAGE 6-56  
BY CAROLYN  
FRANUS  
VOID  
ASTER # 18614

365.64

2022.24