


016
.61A.

026-B

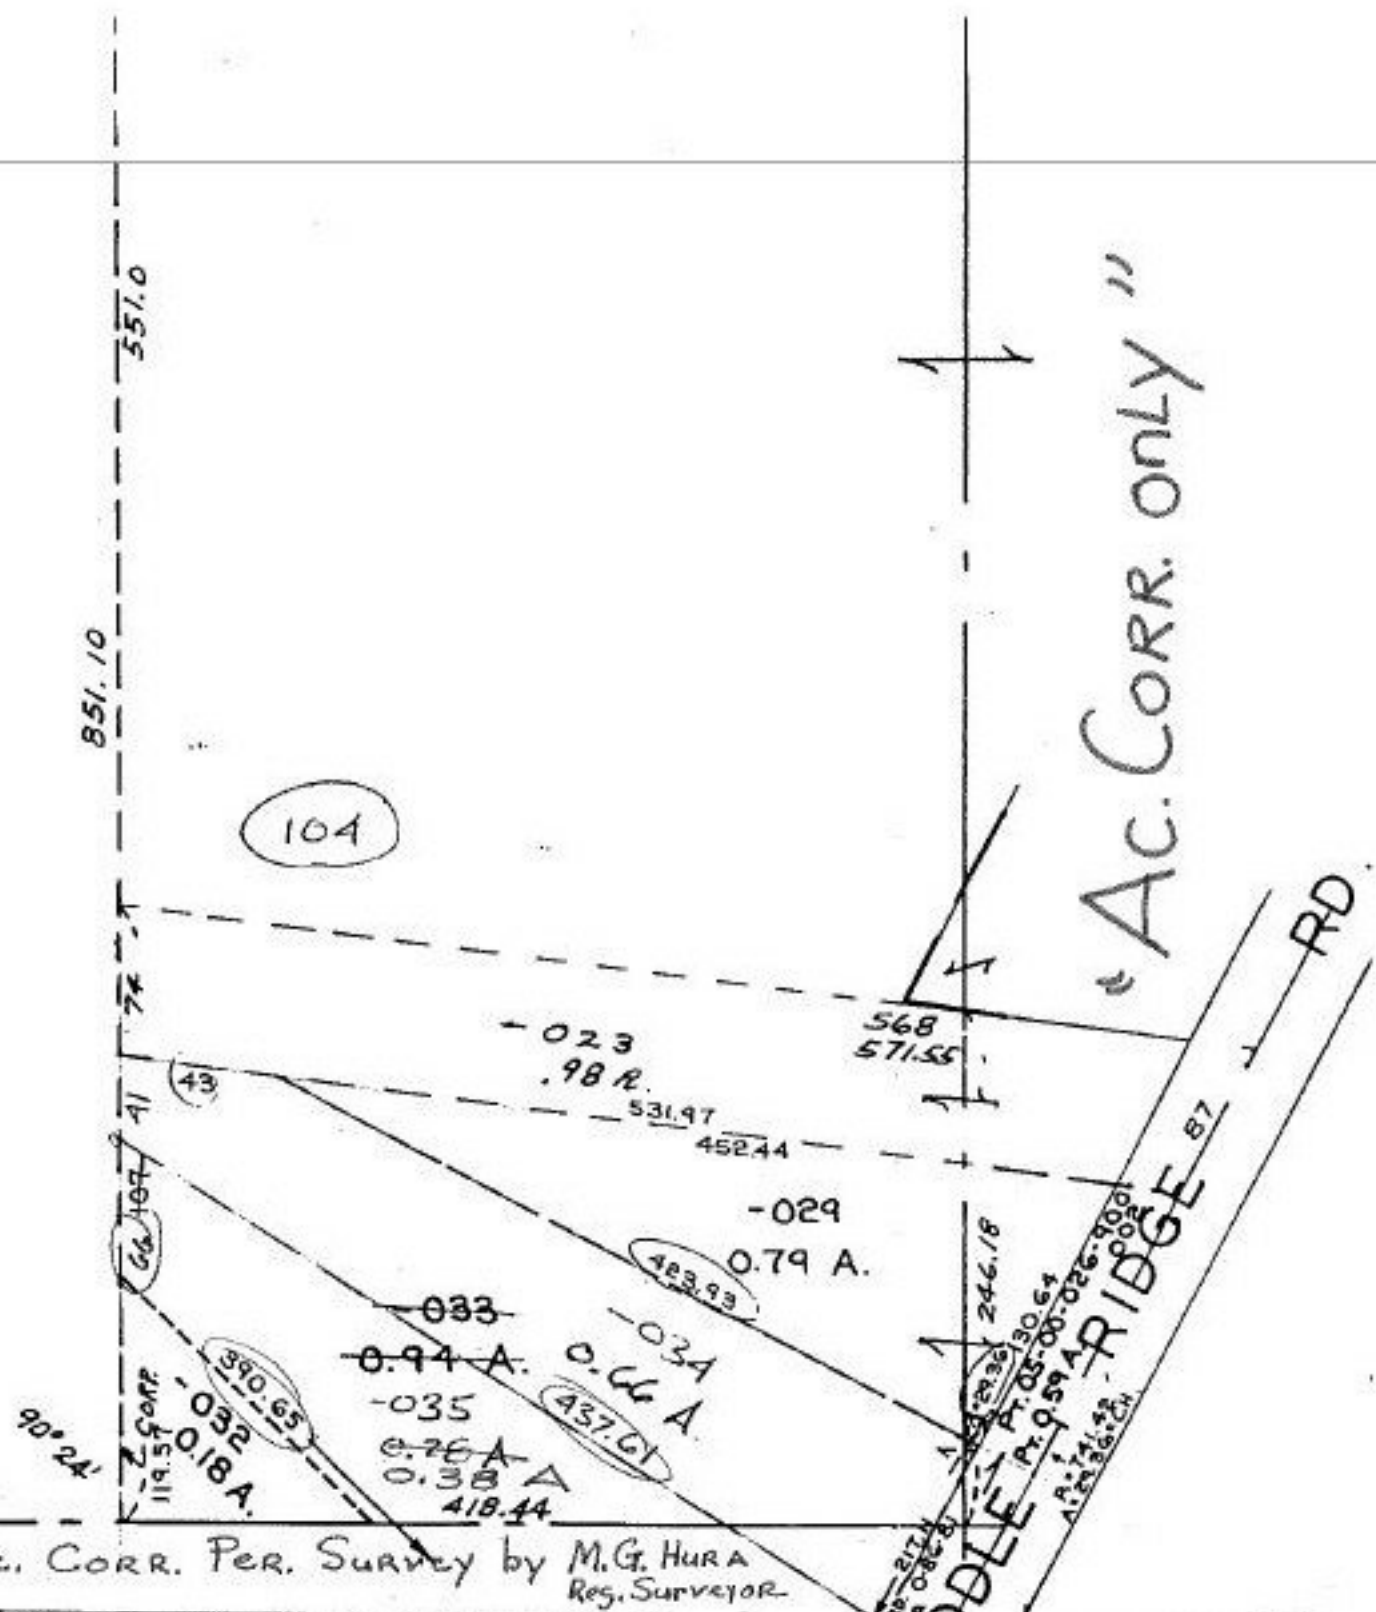

Ac. CORR. PER. SURVEY BY M.G. HURA
REG. SURVEYOR

SEE SURVEY MAP BY
M. G. HURA
CL ~~11,000,000~~
PRIOR INST REF. - 684/513

As shown #18617-A C = 1125,000

10/12/89
#18617-A

APPROVED
LORAIN CO.
MAP DEPT.
DATE 9-15-89
PAGE 5-00-025-B
BY CAROLYN
FRANZIS

#18541
APPROVED
LORAIN CO.
MAP DEPT.
DATE 7-1-89
PAGE 5-00-025-B
BY M. HURA
18541