


QUARRY *Smith* 21A #1862 RD.

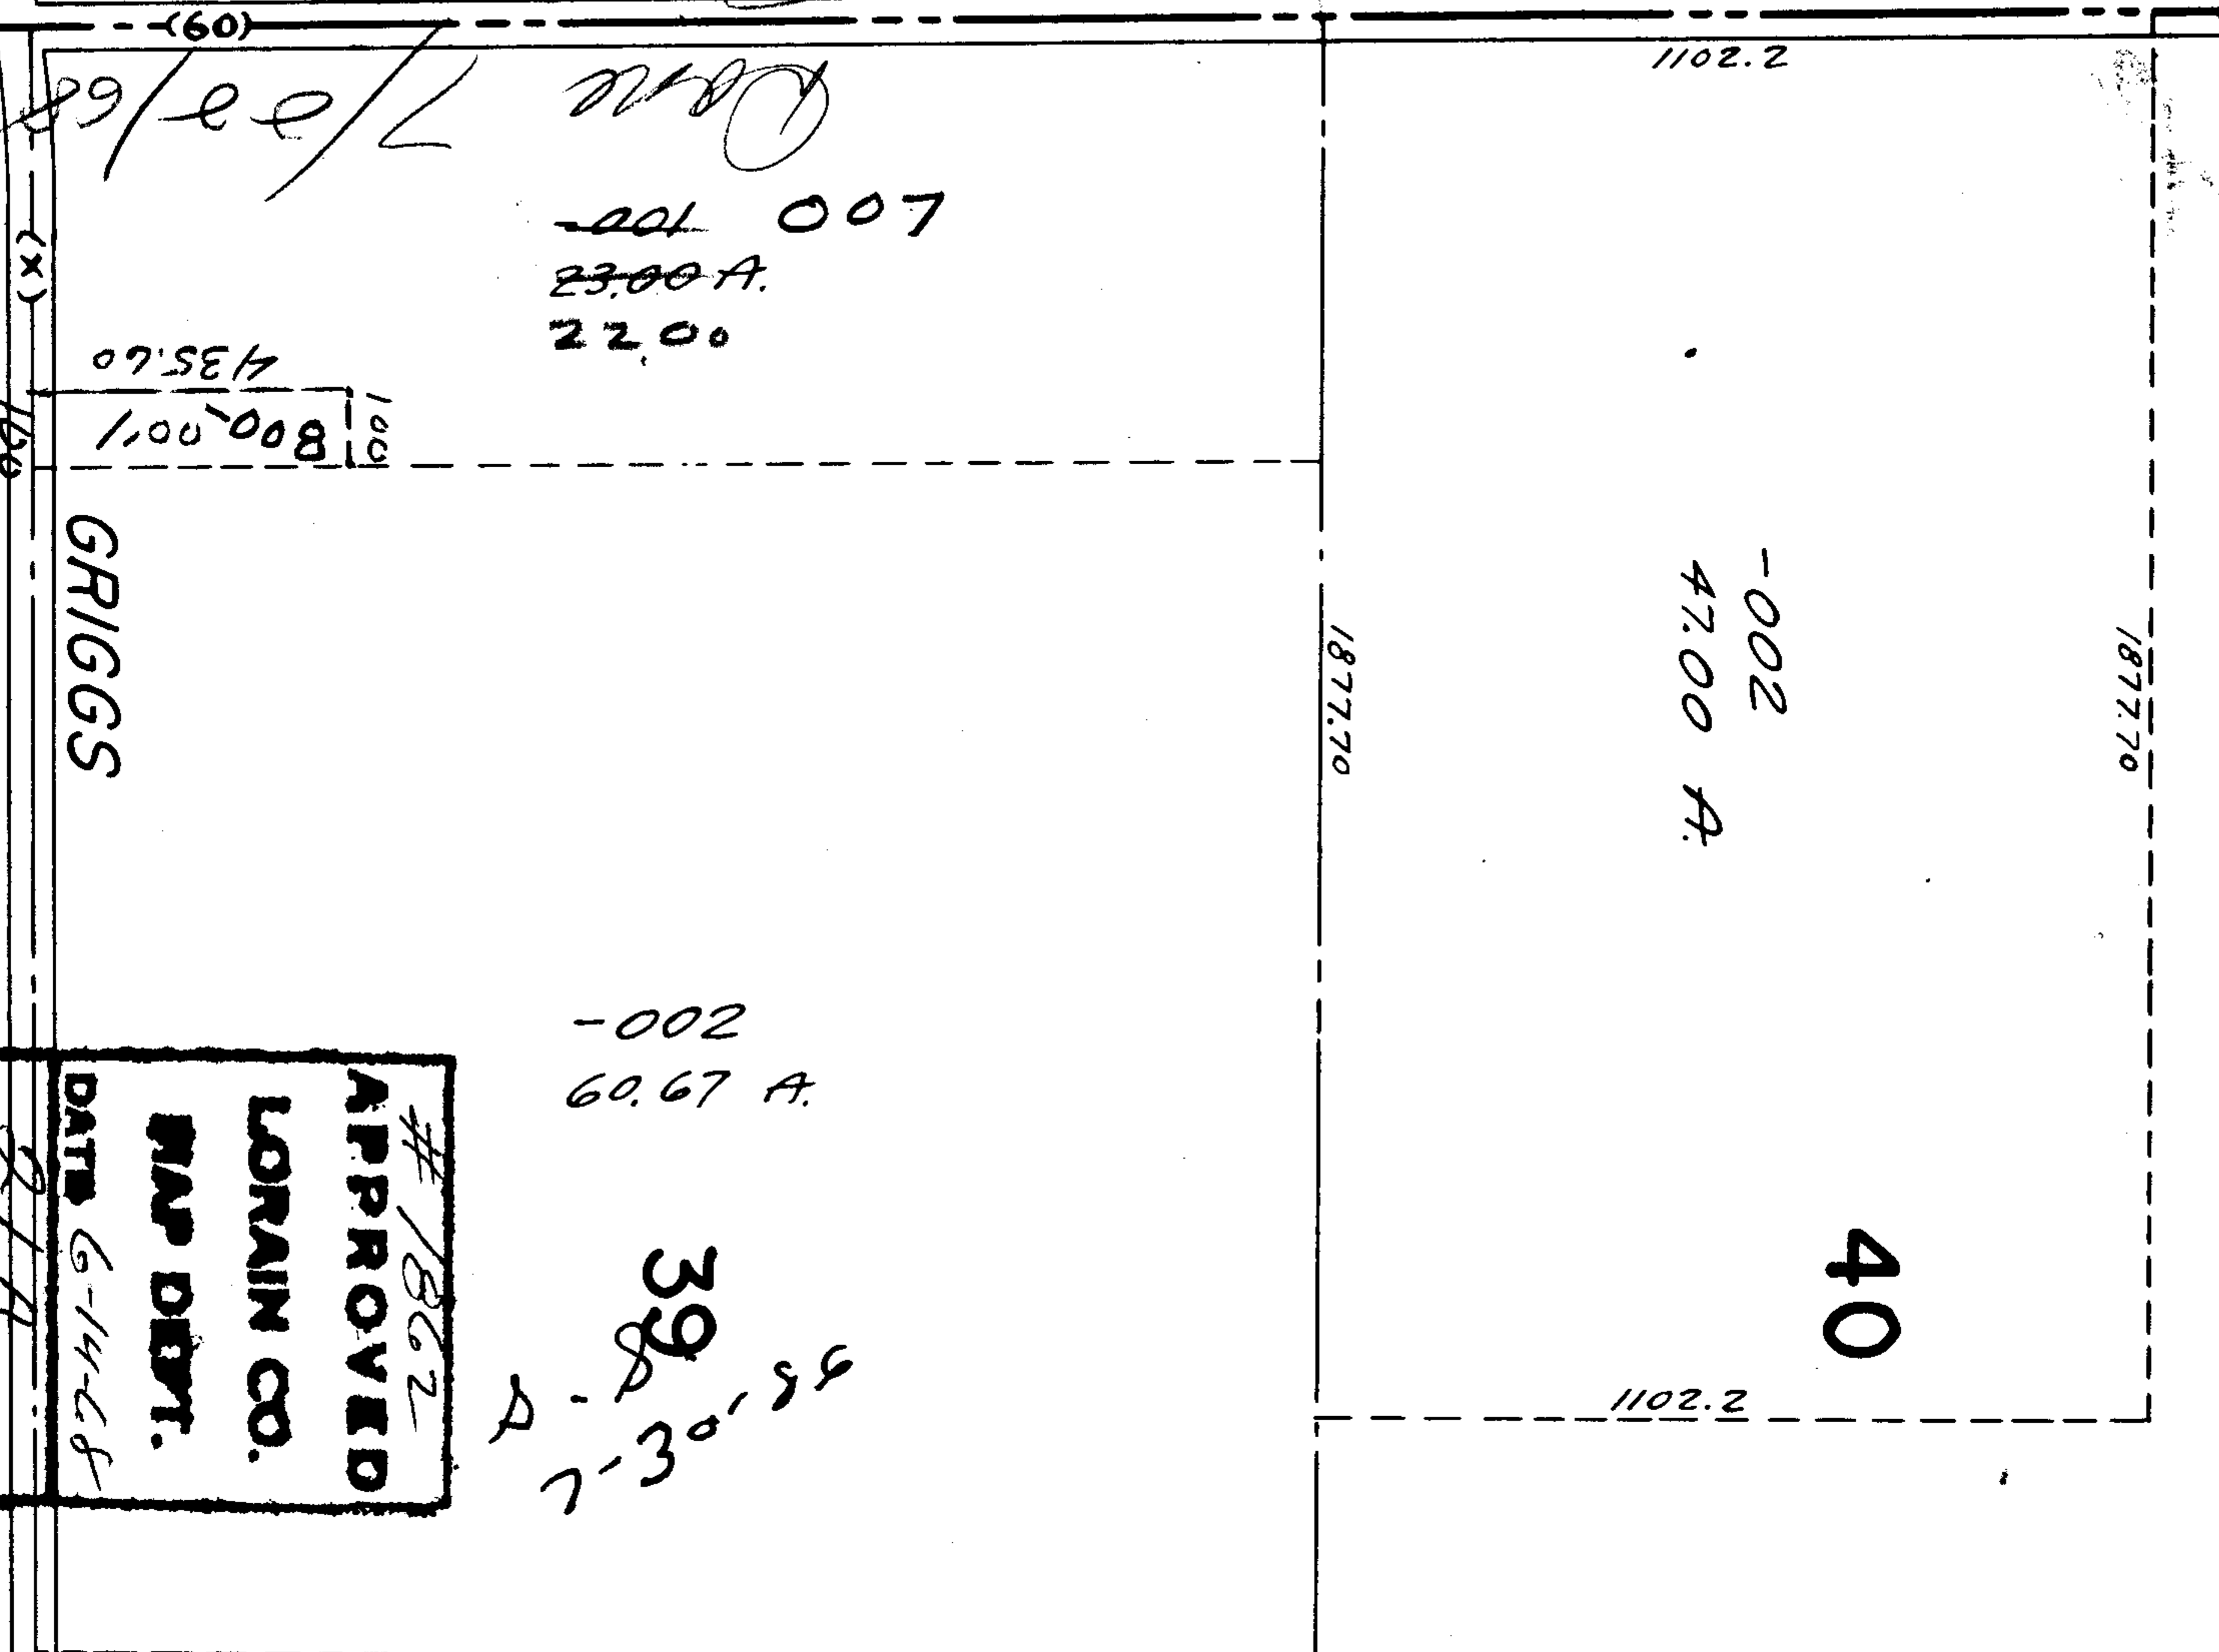

7/22/68
 001 007
 23.00 A.
 22.00
 435.60
 800.001
 100

GRIGGS

-002
 60.67 A.

39
 7-30-88
 58-00
 A

40

#1862
 APPROVED
 LORAIN CO.
 MAP DEPT.
 DATE 6-14-68
 BY LNH

-003 6.33 A.


-003
 2.00 A.

-006
 39.25 A.

-004
 38.00 A.

600
 -005
 2.75 A.
 600

-001
 52.2

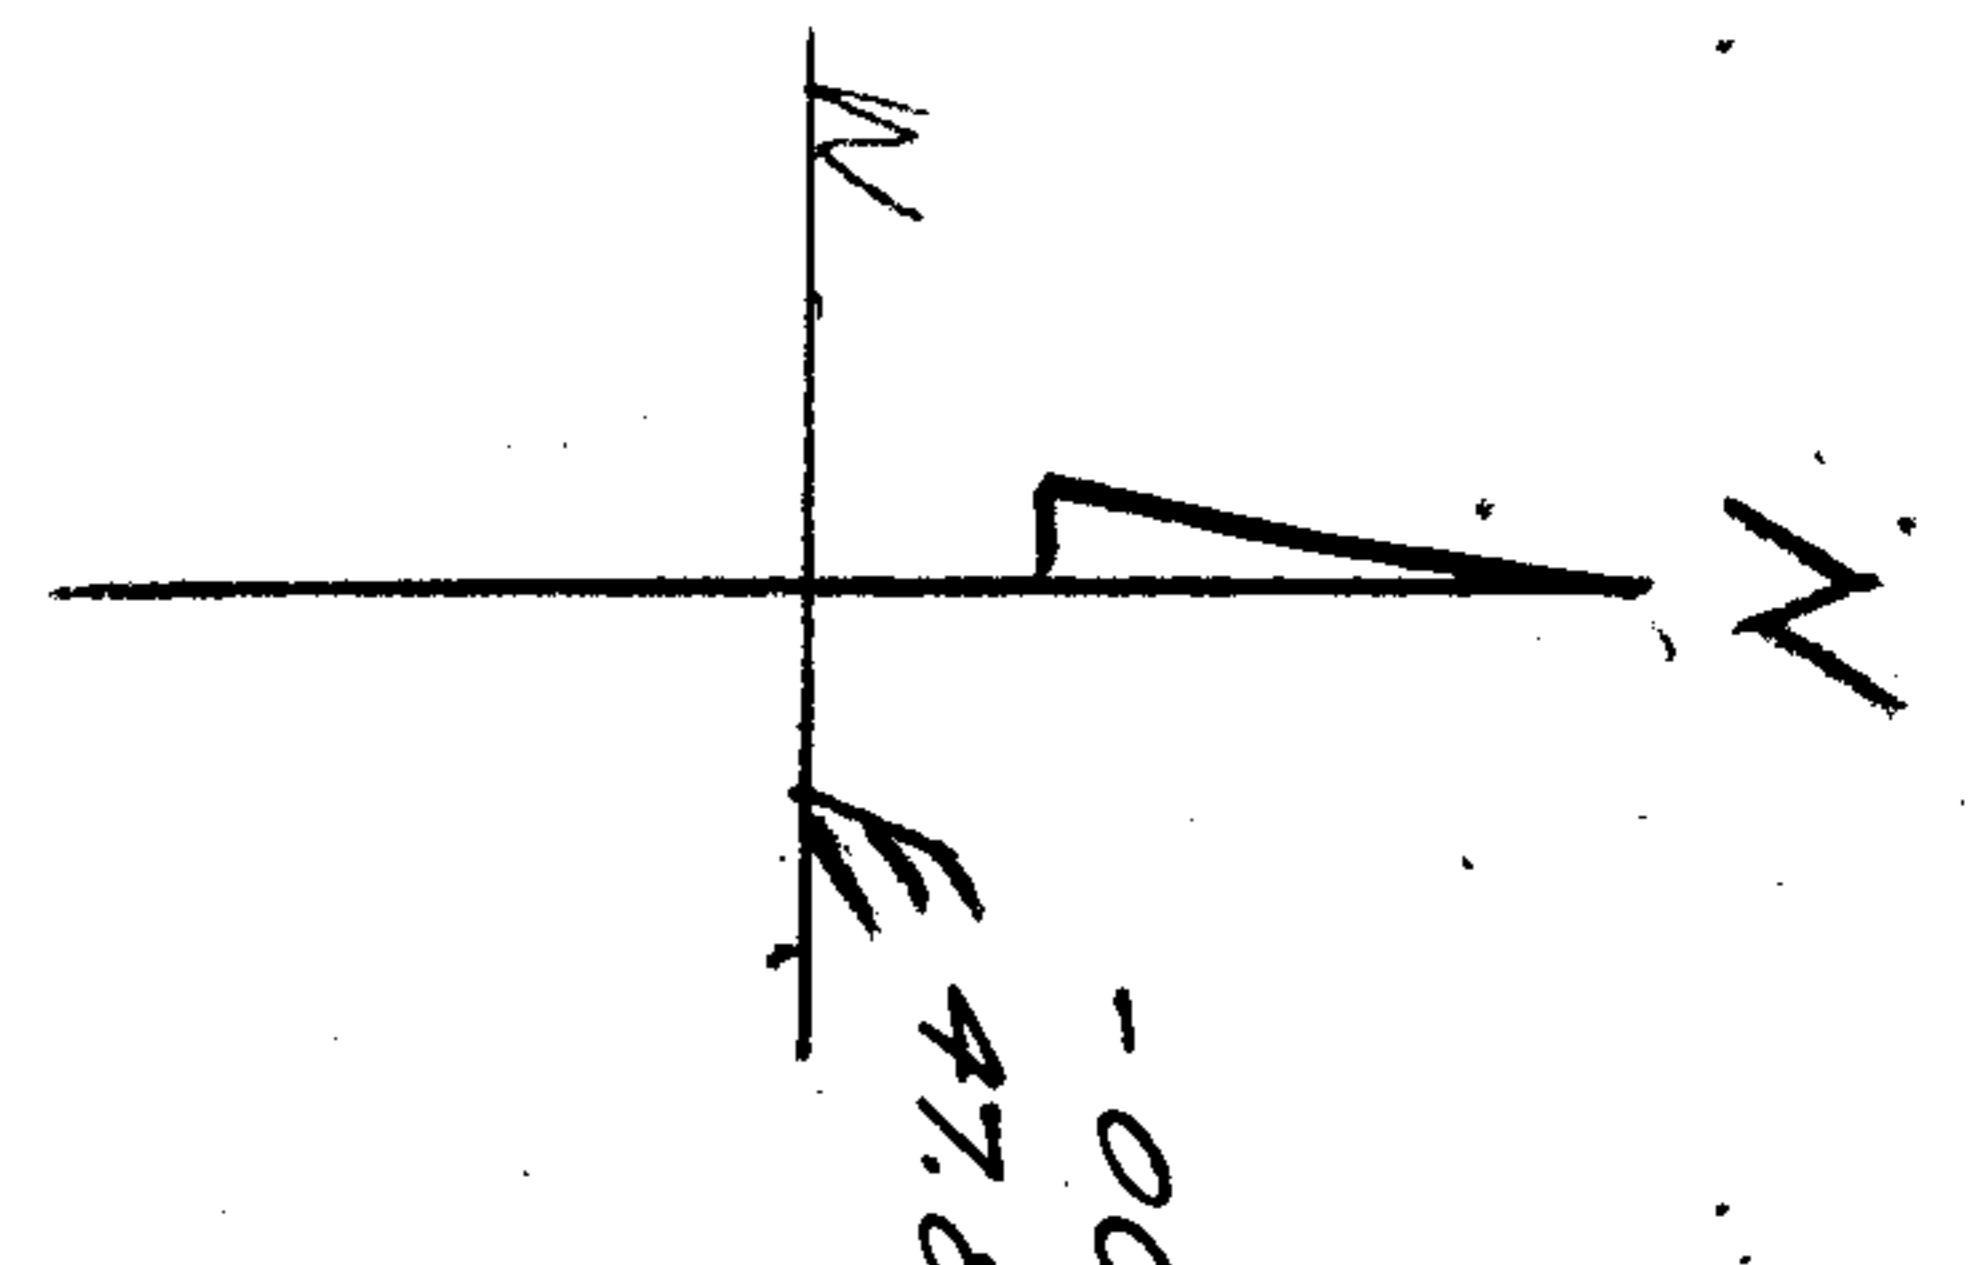

Signature

Signature