


-009 3.49 A
 SPLIT 2.43 A
 REM. 1.06 A

N
 W. LINE 295.00
 REM. 90.00
 SPLIT 2.05.00
 S. LINE 295.00
 REM. 90.00
 SPLIT 2.05.00

18-00-012-000-011 PRIOR INST. 133/661
 SURVEYED BY: JOHN R. HAMILTON REG. SURV.
 C-1: INF.

130
 130
 -003
 0.39 A.

JONES

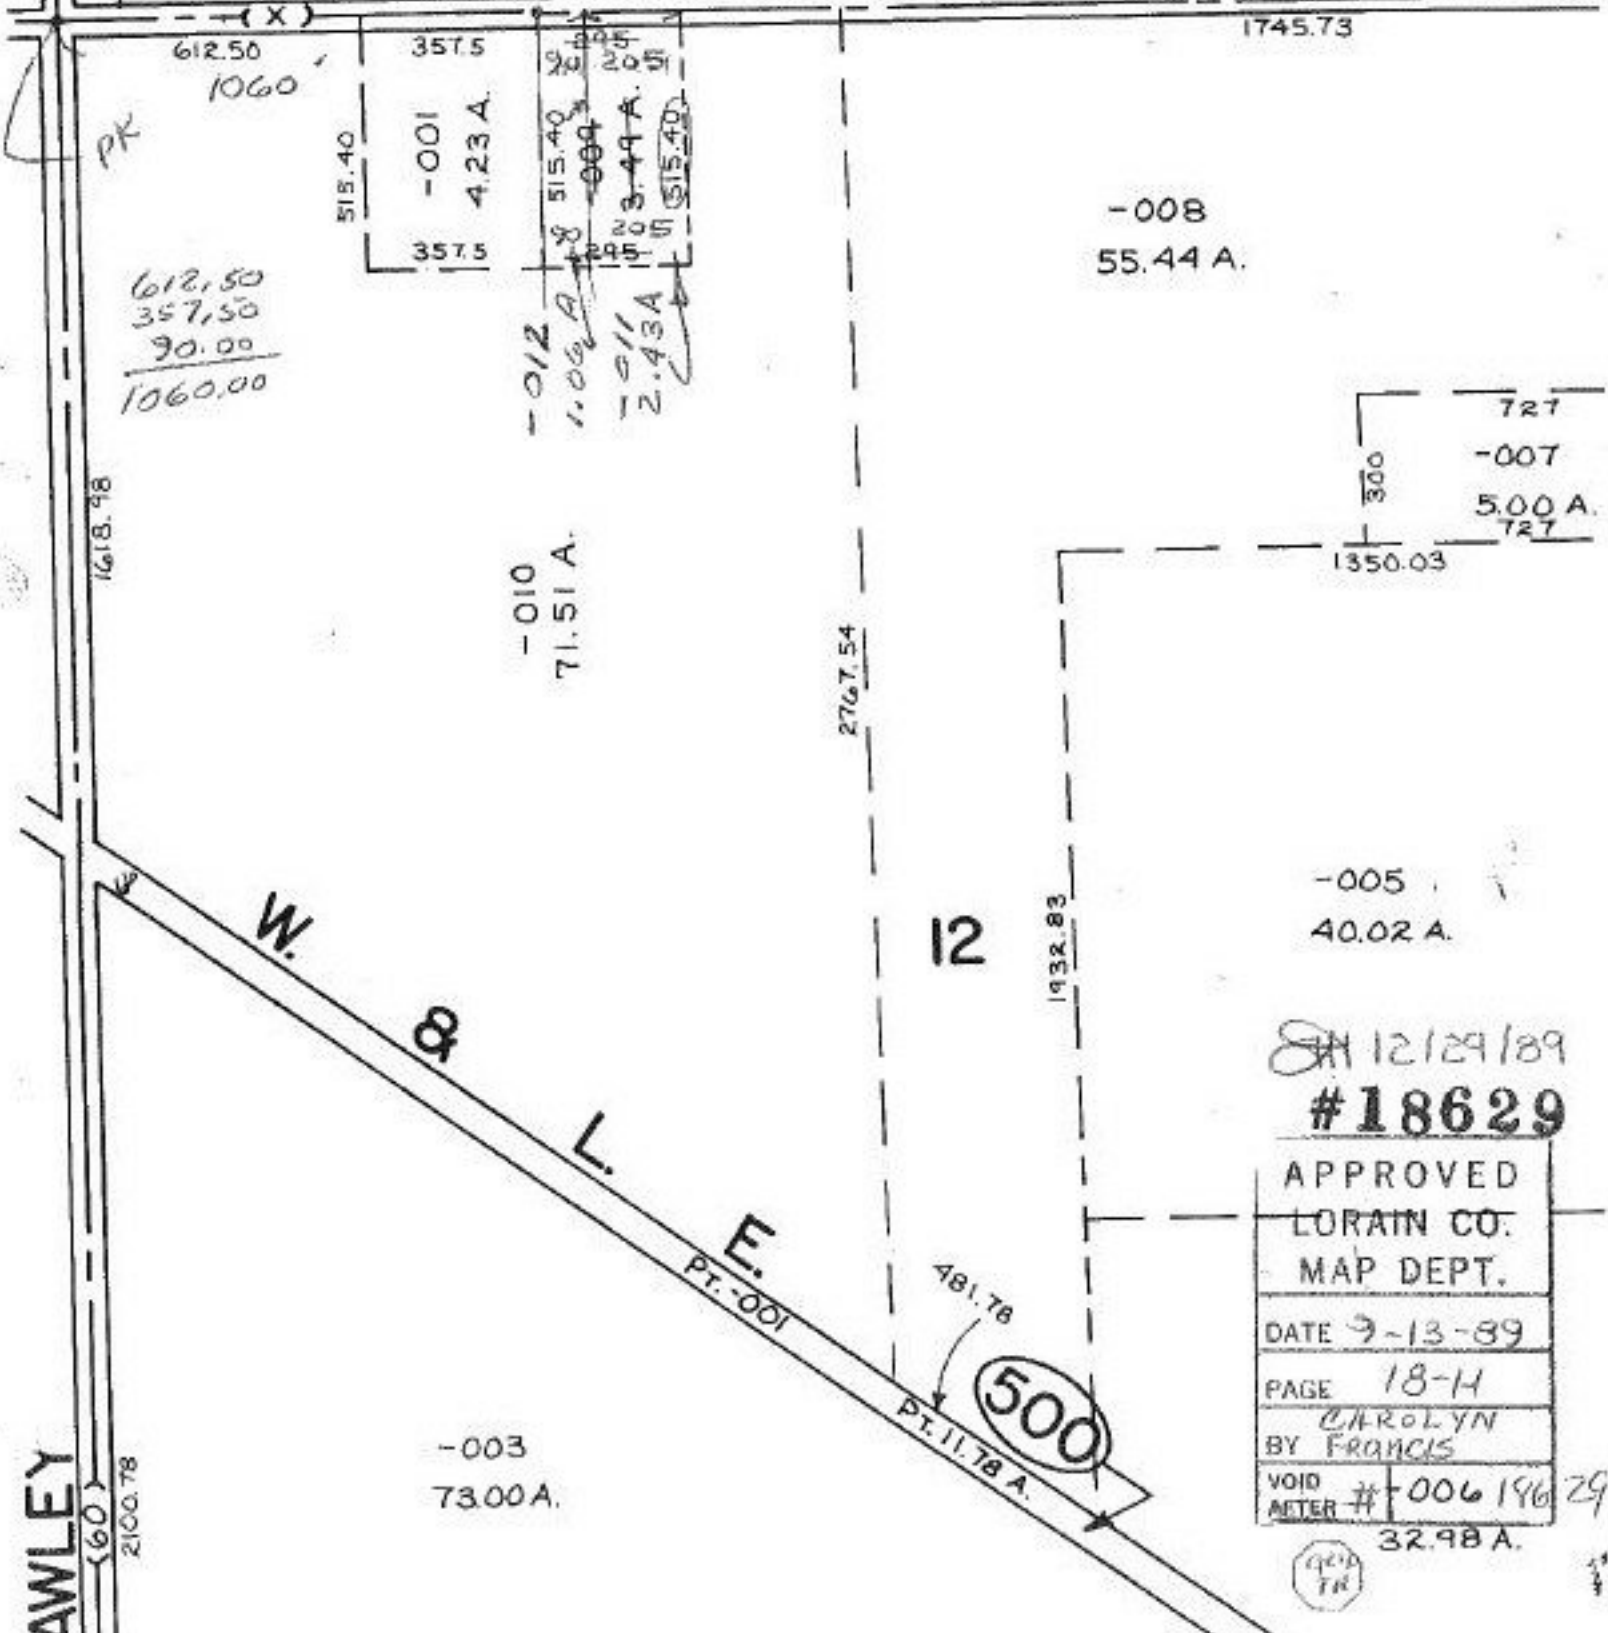

612.50
 357.50
 90.00
 1060.00

515.40
 -001
 4.23 A.
 357.5
 515.40
 515.40
 3.49 A.
 2.43 A.
 515.40

-010
 71.51 A.

-008
 55.44 A.

300
 727
 -007
 5.00 A.
 727

-005
 40.02 A.

12/29/89
 #18629

APPROVED
 LORAIN CO.
 MAP DEPT.
 DATE 9-13-89
 PAGE 18-14
 BY FRANCIS
 VOID AFTER # 006196
 32.98 A.

AWLEY
 (60)
 2100.78

-003
 73.00 A.

481.78
 500
 Pt. 11.78 A.

