


ER FOSTER PARK

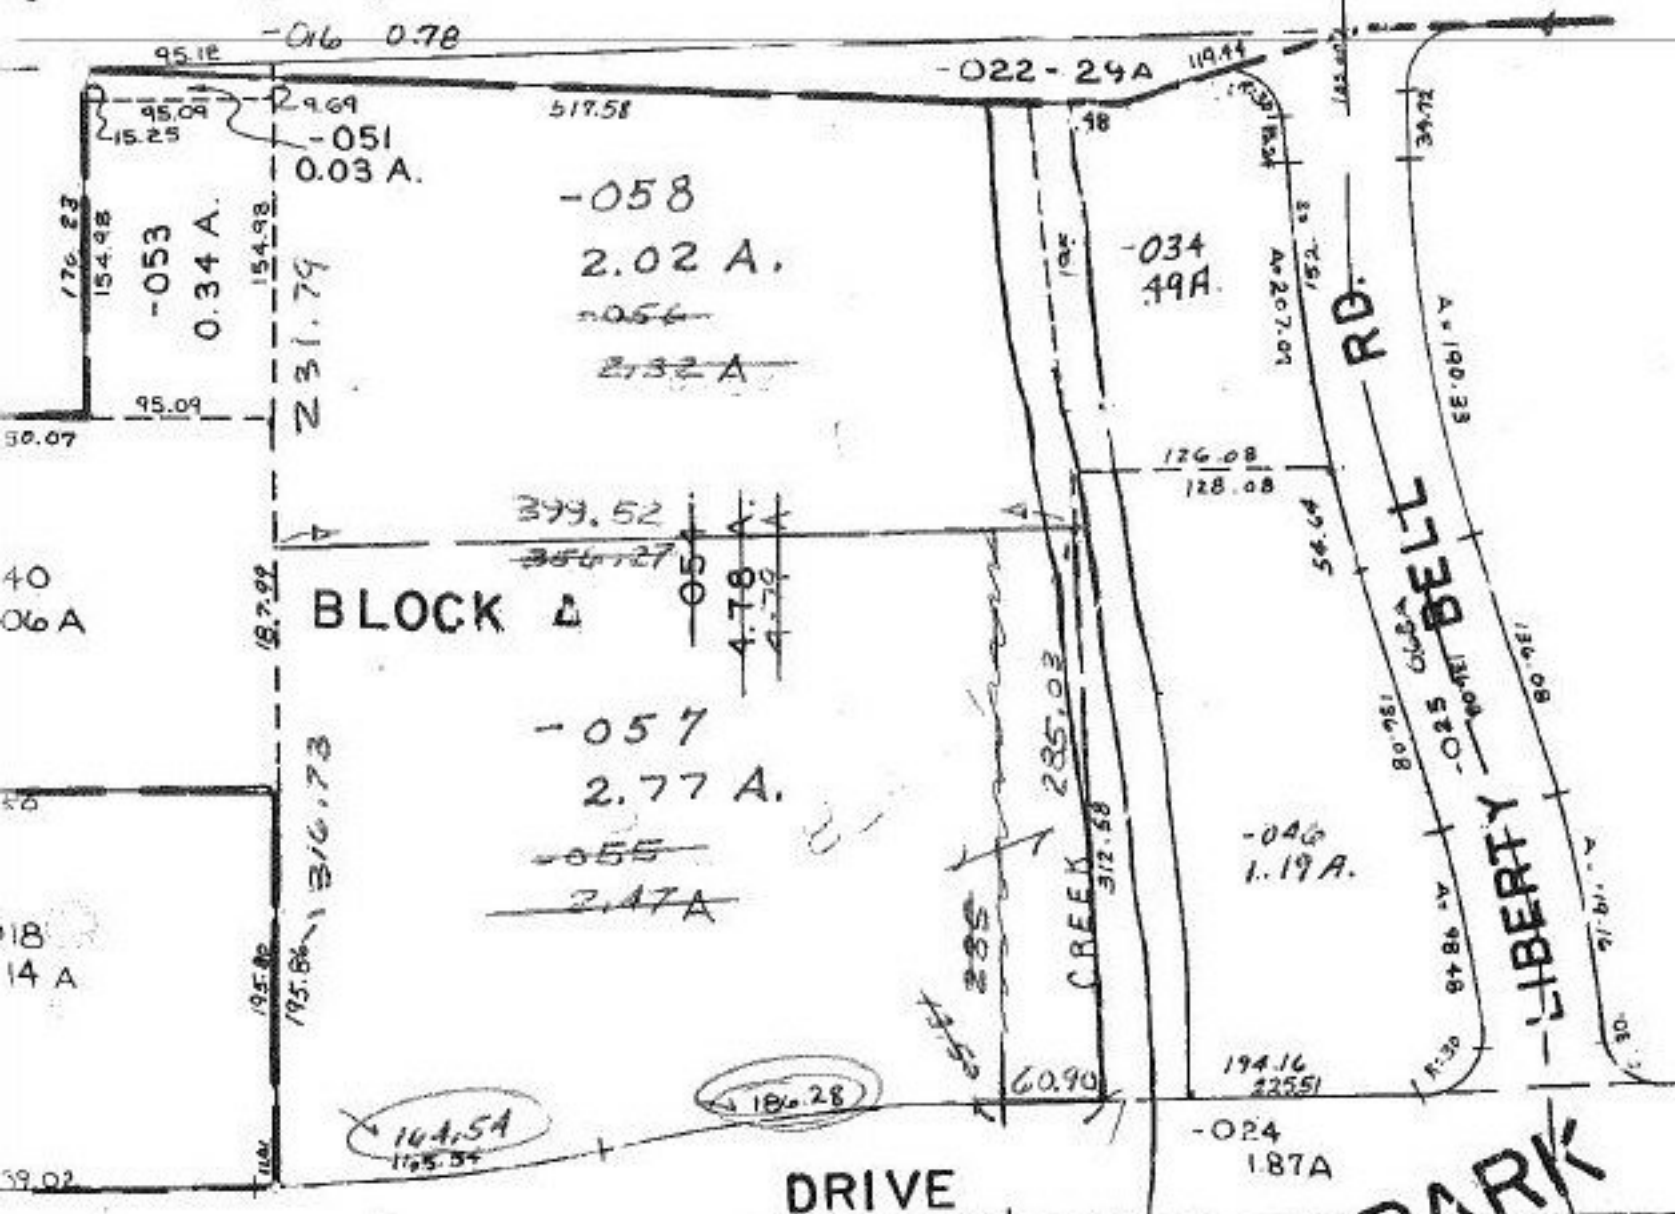

BLOCK A

316.73

164.54
175.54

-057
2.77 A.
~~-055~~
2.47 A

-058
2.02 A.
~~-056~~
2.32 A

-034
49A

-046
1.19 A.

-024
187A

101

05-00-041-101- P. INST. 1122/149
SURVEYED BY: M. G. HURA REG. SURV.
C=1:29,411.

-056 2.32
-055 2.47
4.79
SPLIT 2.77
Rem 2.02

BLOCK C
-049
5.43 A.

PARK

PG. 2

#18630

APPROVED
LORAIN CO. MAP DEPT.
DATE 9-14-89
PAGE 5-00-041A
BY CAROLYN FRANCIS
VOID AFTER #18630

033
PT BLC
10.14

INDEPENDENCE
VOL. 30