


500

20

108

MIDWA

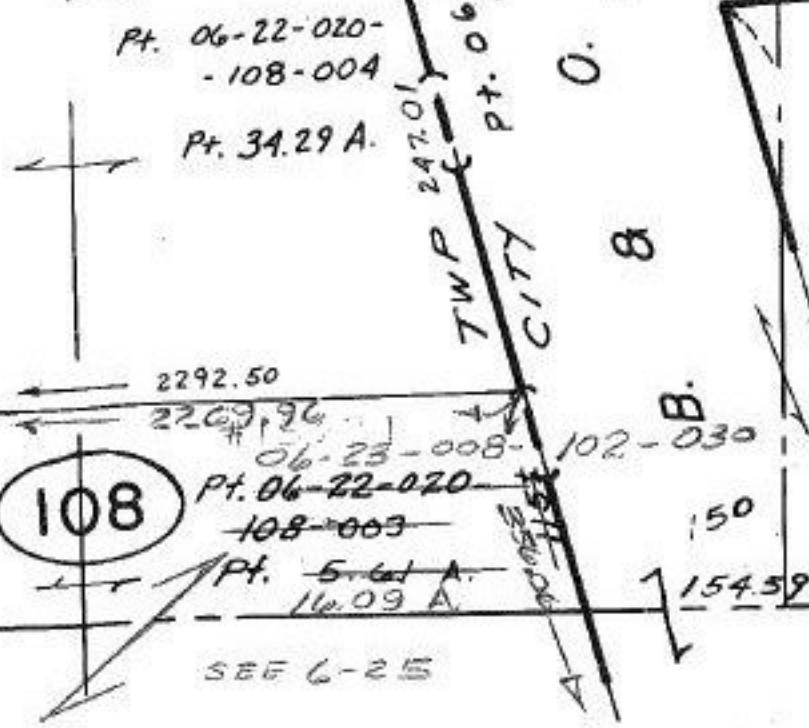

SIN 10/18/89
#18631

APPROVED
LORAIN/CO.
MAP DEPT.

DATE 9-14-89

PAGE 6-7
BY CAROLYN
FRANCIS

VOID AFTER # 18631

06-23-008-102- C=1:333,333. PRIOR INST. 1298/772
06-22-020-108- SURVEYED BY: LAUNDON, SIMON, CAHL & AS.

BURRELL & DAY TRACT W-LY PT. LOTS 168 & 20