

10	172	40	30	173	174	175	176	177	178	179	180	181	182	183	184	185	186	187	188	189	190	191	192	193	194	195	196	197	198	199	200
100	155.037	40	30	154.038	153.039	152.040	151.041	150.042	149.043	148.044	147.045	146.046	145.047	144.048	143.049	142.050	141.051	140.052	139.053	138.054	137.055	136.056	135.057	134.058	133.059	132.060	131.061	130.062	129.063	128.064	127.065

STATE

SUPERIOR

30	28.001	30	30	29.002	29.003	29.004	29.005	29.006	30.007	30.008	31.009	32.010	33.011	34.012	35.013	36.014	37.015	38.016	39.017	40.018	41.019	42.020	43.021	44.022	45.023	46.024	47.025	48.026	49.027	50.028	51.029	52.030	53.031	54.032
30	27.002	30	30	26.003	25.004	24.005	23.006	22.007	21.008	20.009	19.010	18.011	17.012	16.013	15.014	14.015	13.016	12.017	11.018	10.019	9.020	8.021	7.022	6.023	5.024	4.025	3.026	2.027	1.028	0.029	0.030	0.031	0.032	

GLOBE

#18631

APPROVED
LORAIN CO.
MAP DEPT.
DATE 9-14-89
PAGE 6-6
BY CAROLYN
FRANCIS
VOID # 18631
2292.50


R. 5839.65 CH. = 611.15 (612.37) A = 611.15

L. V. W. A. B. V.
+ (P. 10.26A) 06-22-020-108-003 S. 61 A.
(P. 20.50A) 06-23-008-102-027 10.57 A.
0.76 16.18 A.
16.39 A.

Pt. 06-22-020-108
Pt. 34.29 A.

AL. Change per Survey 3.99A
5.76A Remains E

2269.96
2269.96
06-23-008-102-030
Pt. 06-22-020-108-003
Pt. 5.61 A. 16.09 A.

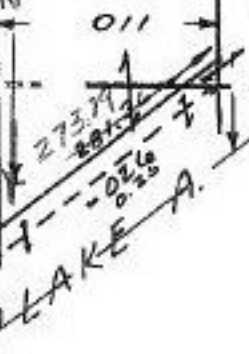

06-23-008-102- C-1:333,333. PRIOR INST. 1298/772
06-22-020-108- SURVEYED BY: LAIRDON, SIMON, CAHL & ASSOC.

SEE