


874.1
102

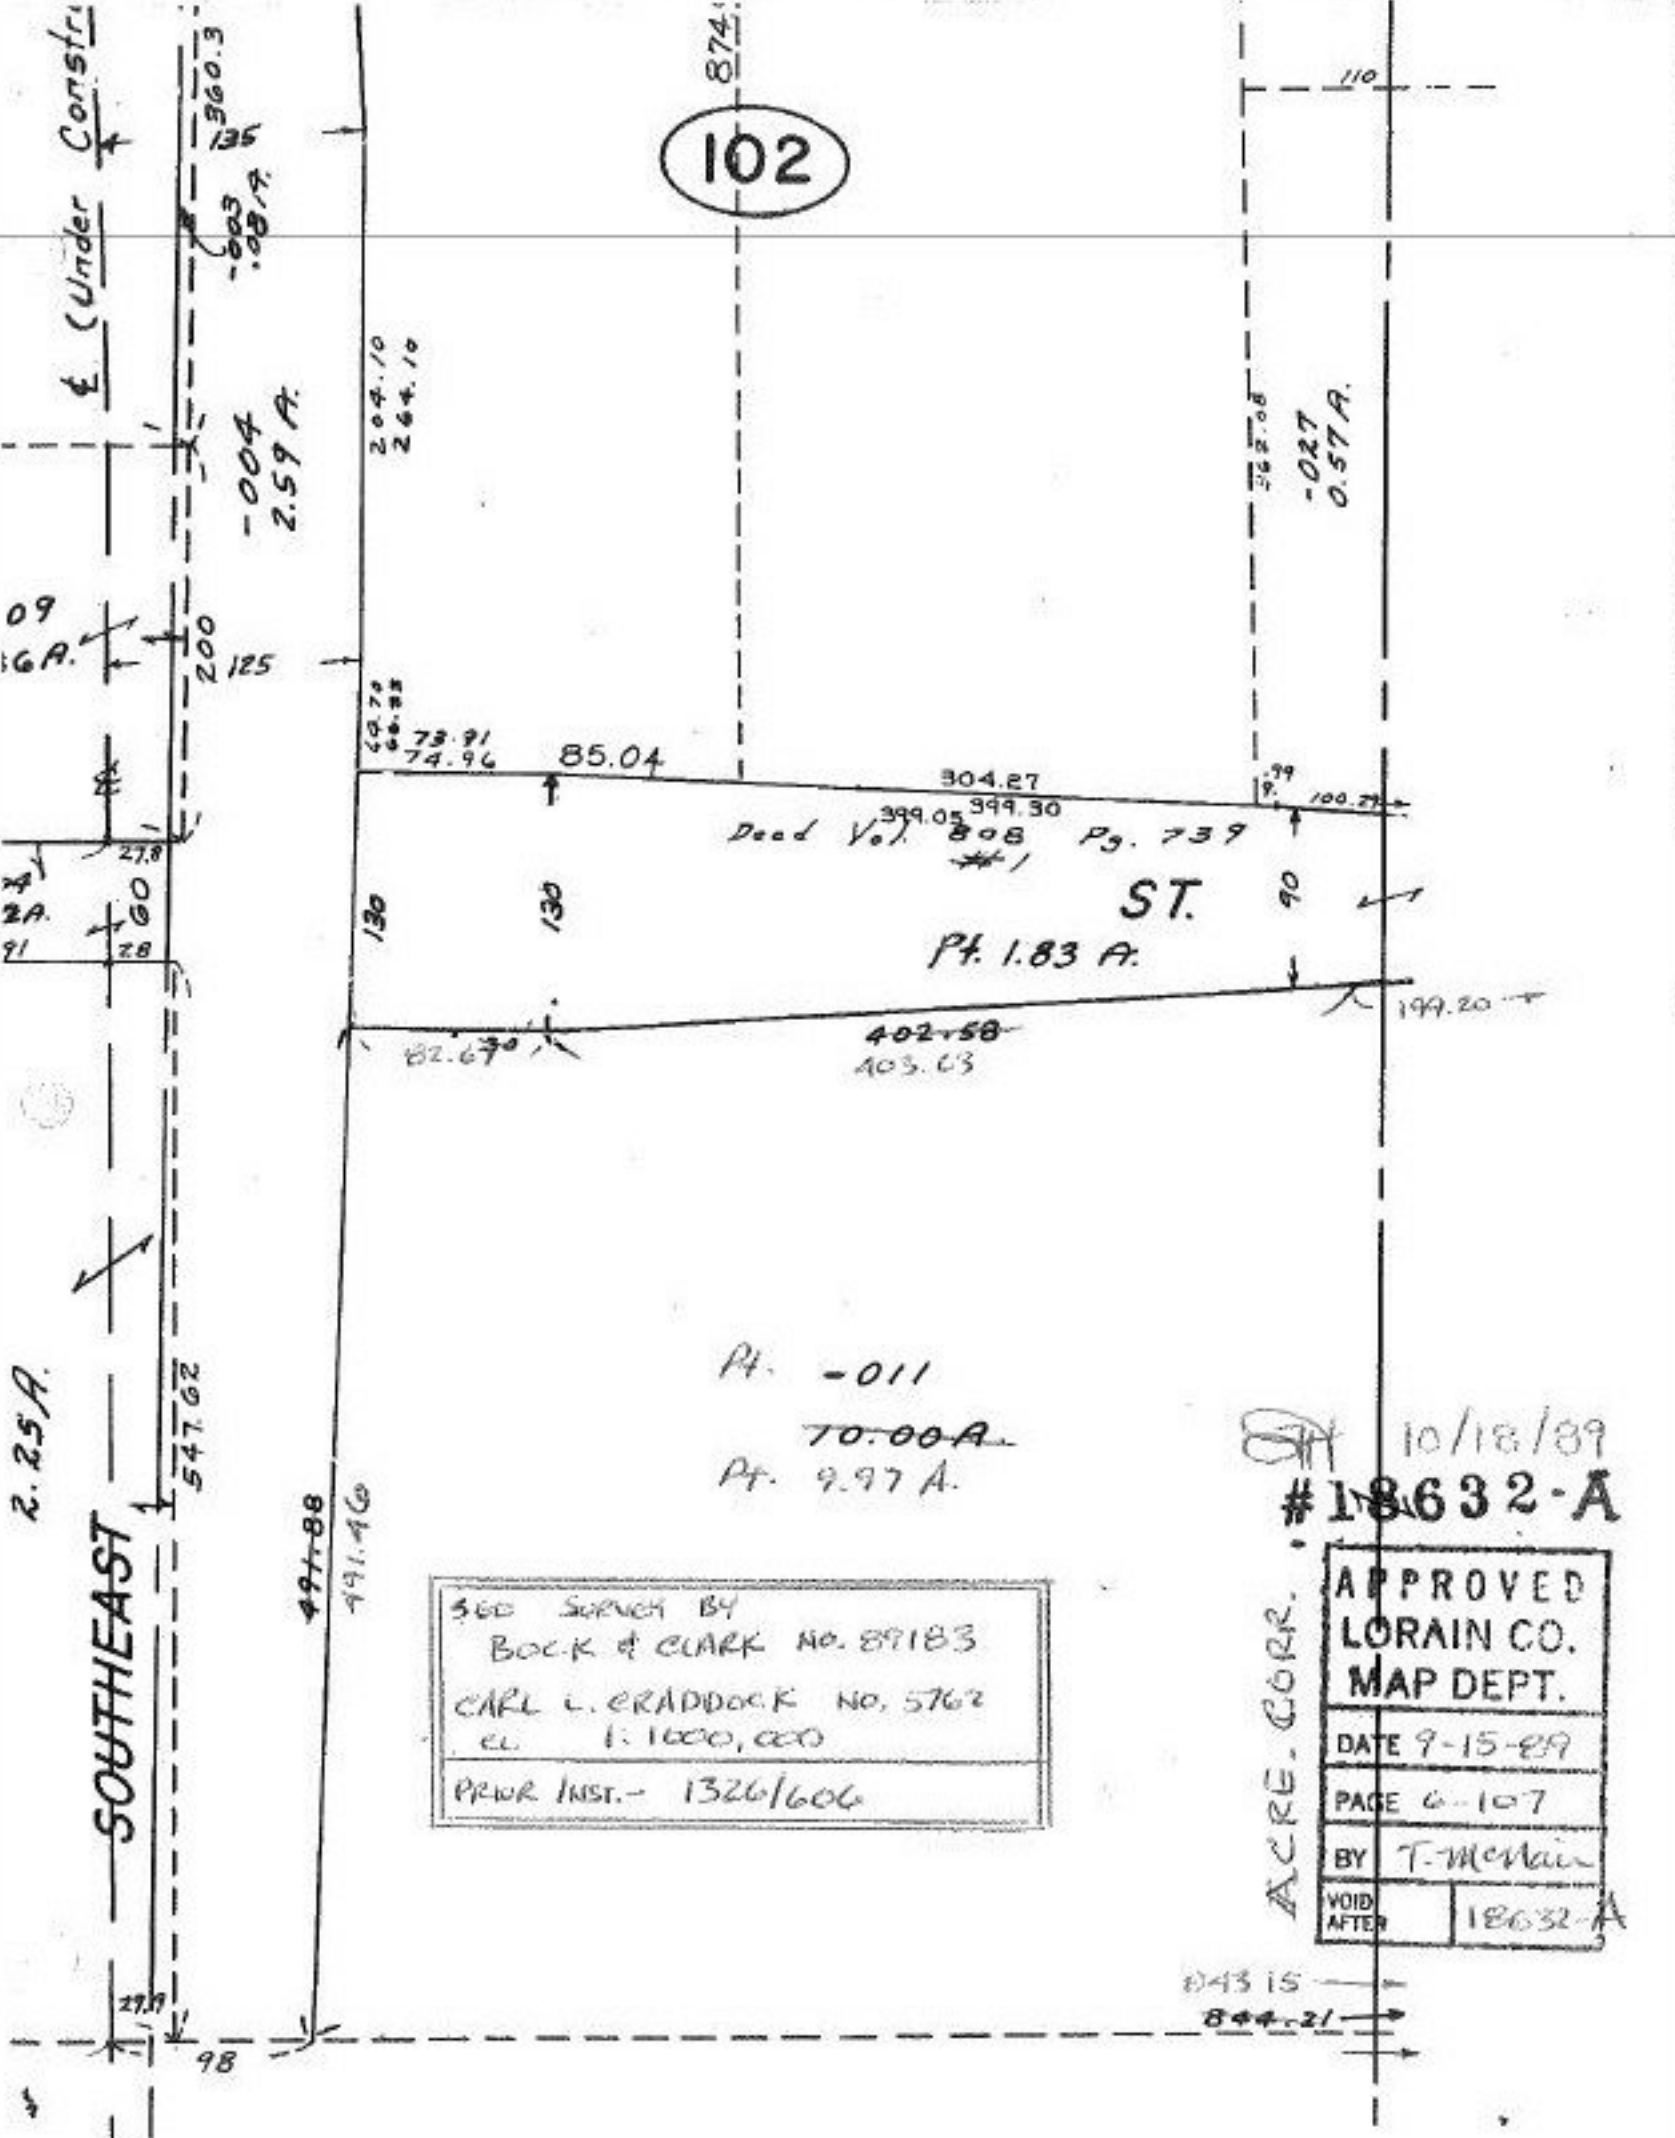

Under Constr.
09
16 A.
200
125
20
2A
91
28
27.8
2.25 A.
SOUTHEAST
27.9
98

-004
2.59 A.

204.10
264.10

50.79
56.83
73.91
74.96

85.04

304.27
399.05
399.30
Deed Vol. 808 Pg. 739
#1

ST.
Pt. 1.83 A.

562.08
-027
0.57 A.

82.67

402.58
403.63

199.20

Pt. -011
70.00 A.
Pt. 9.97 A.

360 SURVEY BY
BOCK & CLARK NO. 89183
CARL L. GRADDOCK NO. 5762
CL. 1:1000, 000
PROR INST. - 1326/606

10/18/89
#18632-A

ACRE. CORR.
APPROVED
LORAIN CO.
MAP DEPT.
DATE 9-15-89
PAGE 6-107
BY T-McNair
VOID AFTER 18632-A

043.15
844.21