

Deed Covers P.R.No. ① Problem: Description is not complete.

| | | |
|--------------|-------|---|
| -035 | 0.25 | A |
| -036 | 14.89 | |
| -045 | 1.03 | |
| -047 | 0.65 | |
| -048 | 0.20 | |
| -049 | 1.04 | A |
| <u>18.05</u> | | |

Description Leaves out a 100x225 Parcel of Land.
 Answer. Parcel was Missed in Overall Description. See Deed vol. 839/399
 To solve problem change the Place of beginning Distance From 442.30 Feet To 342.30 Feet Then cont. N. 225 Feet Then cont. E. 92.65 Feet Instead of 192.65 Feet.


Exception! - ②

| | | |
|--------------|-------|---|
| -036 | 14.89 | A |
| -035 | 0.24 | A |
| <u>15.13</u> | | A |

② Problem: Acreages on Deed is 17.51 Acreages Acreages Adds up To 18.05 Acreages - Correct Acreage To 18.05.

| | | |
|-------------|------|---|
| -049 | 1.04 | ① |
| -048 | 0.20 | |
| <u>1.24</u> | | |
| -045 | 1.03 | ③ |
| <u>1.03</u> | | |

| | |
|-----------|----------|
| TOTAL AC. | 18.05 |
| EXCEPTION | 17.40 |
| CONVEYING | 0.65 A ✓ |
| -047 | 0.65 A ✓ |

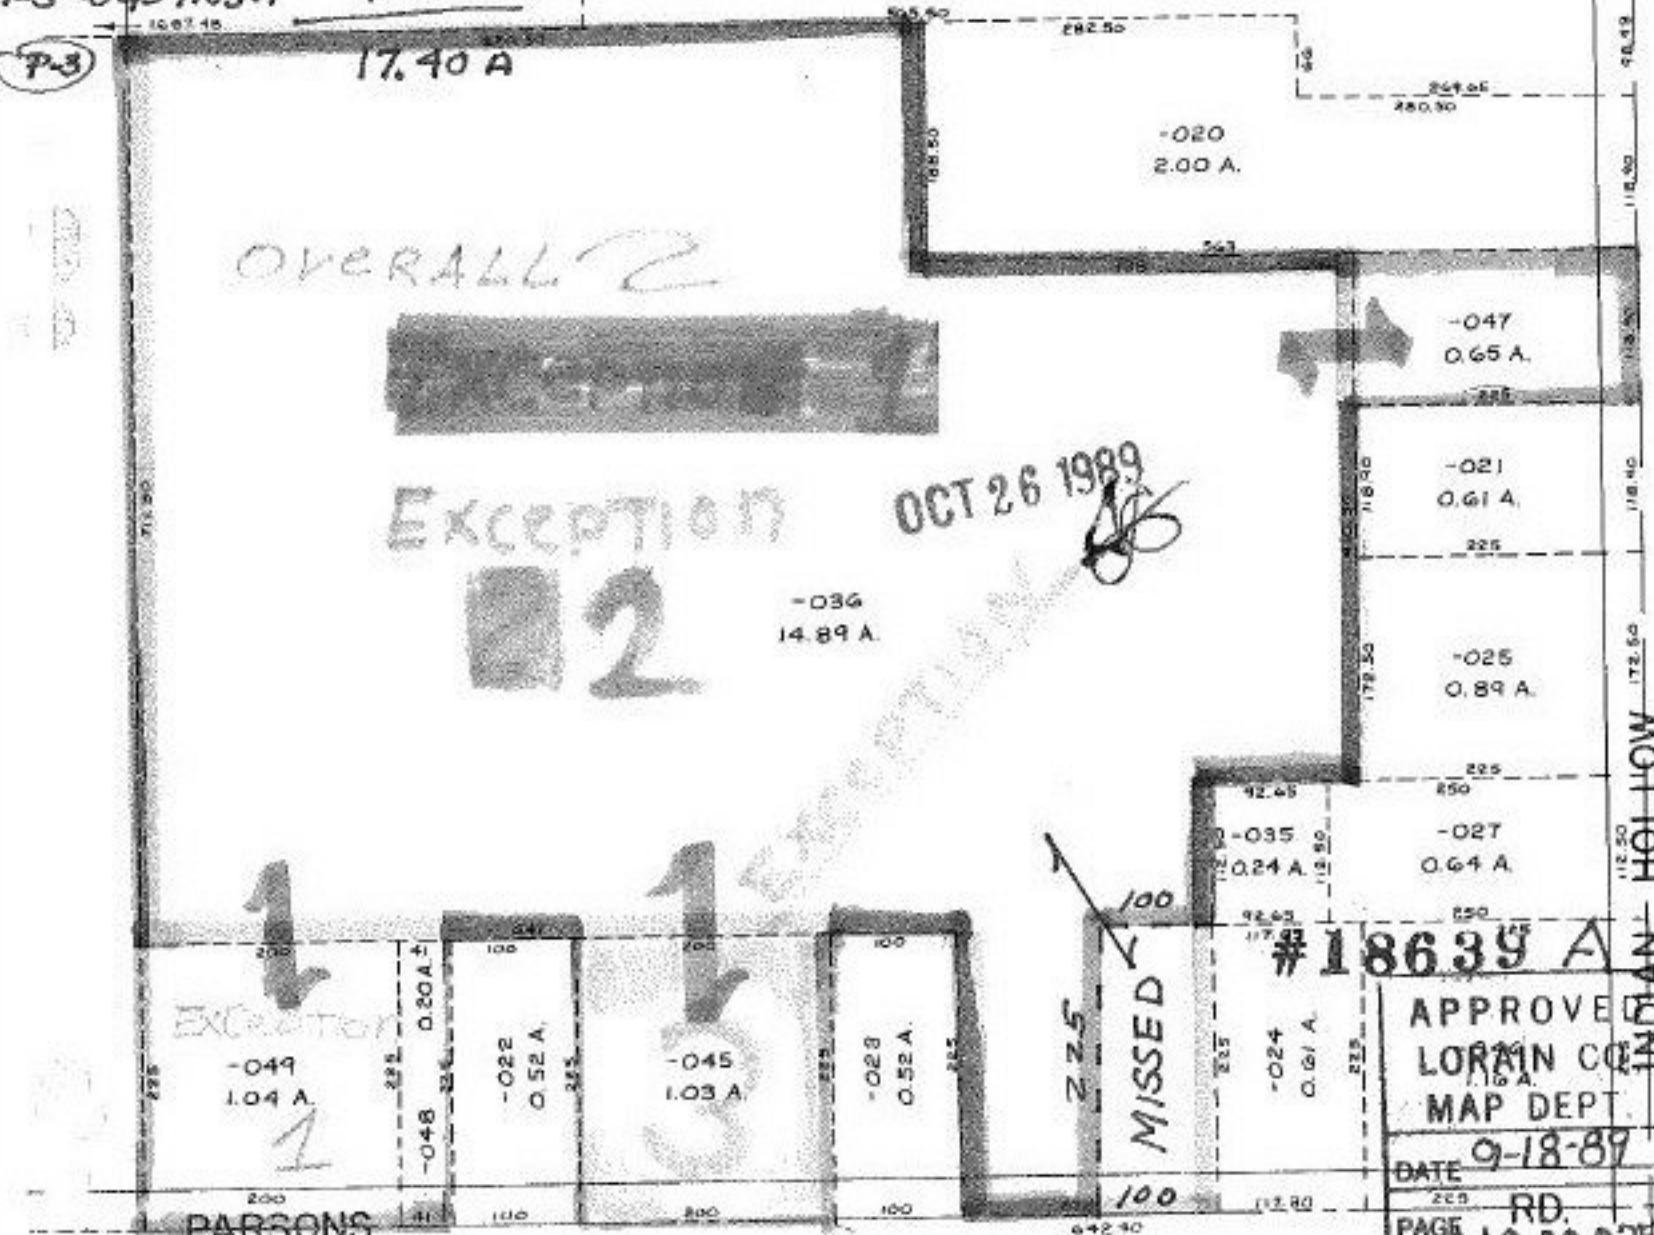

#18639 A
 APPROVED
 LORAIN CO
 MAP DEPT.
 DATE 9-18-89
 RD.
 PAGE 10-00-025
 BY CAROLYN FRANCIS
 VOID #18639-A