


873-51 I.P. Rd.
HAWLEY
 10334
 863-02
 1986-76
 948-95

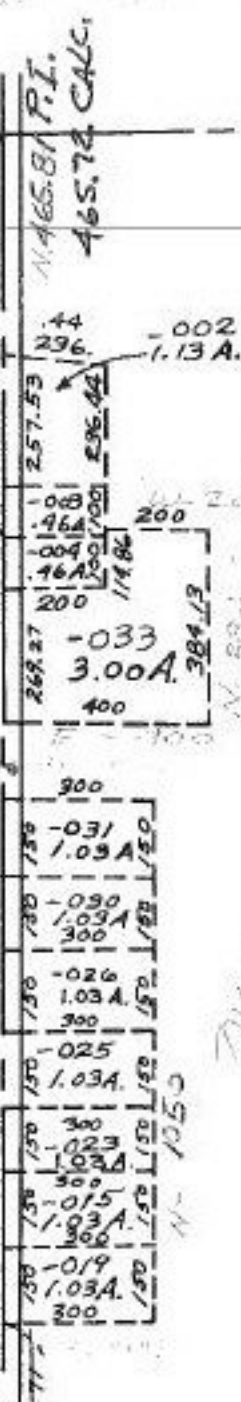

1611.8
 1646.57

~~-041~~
~~-038~~
 125.07A
 116.09A

1,000.00
 1,136.75
 217.80
 270.00
 948.75

-038 125.07
 SPUT(W) 4.01
 121.06
 SPUT(B) 4.97
 116.09

-022
 72.97A.

3512.99

803.51
 200.00
 540.51
 91.25
 1643.08

12/29/89
#18639

APPROVED
 LORAIN CO.
 MAP DEPT.

DATE 9-19-89
 PAGE 18-D
 CAROLYN L. WILKES
NORWALK
 VOID #
 AFTER # 18639

18-00-009-000- PRIOR INST. 1309/365,366
 SURVEYED BY: LAUNDON, SIMON, CAHL & ASSOC.
 (1) & (2) C-1:333,333.

-011
 10.00A.

1216.76

-012
 62.05A

PAGE 807-bead
 Dist 803.51 SURVEY