


MEDINA - NORWALK

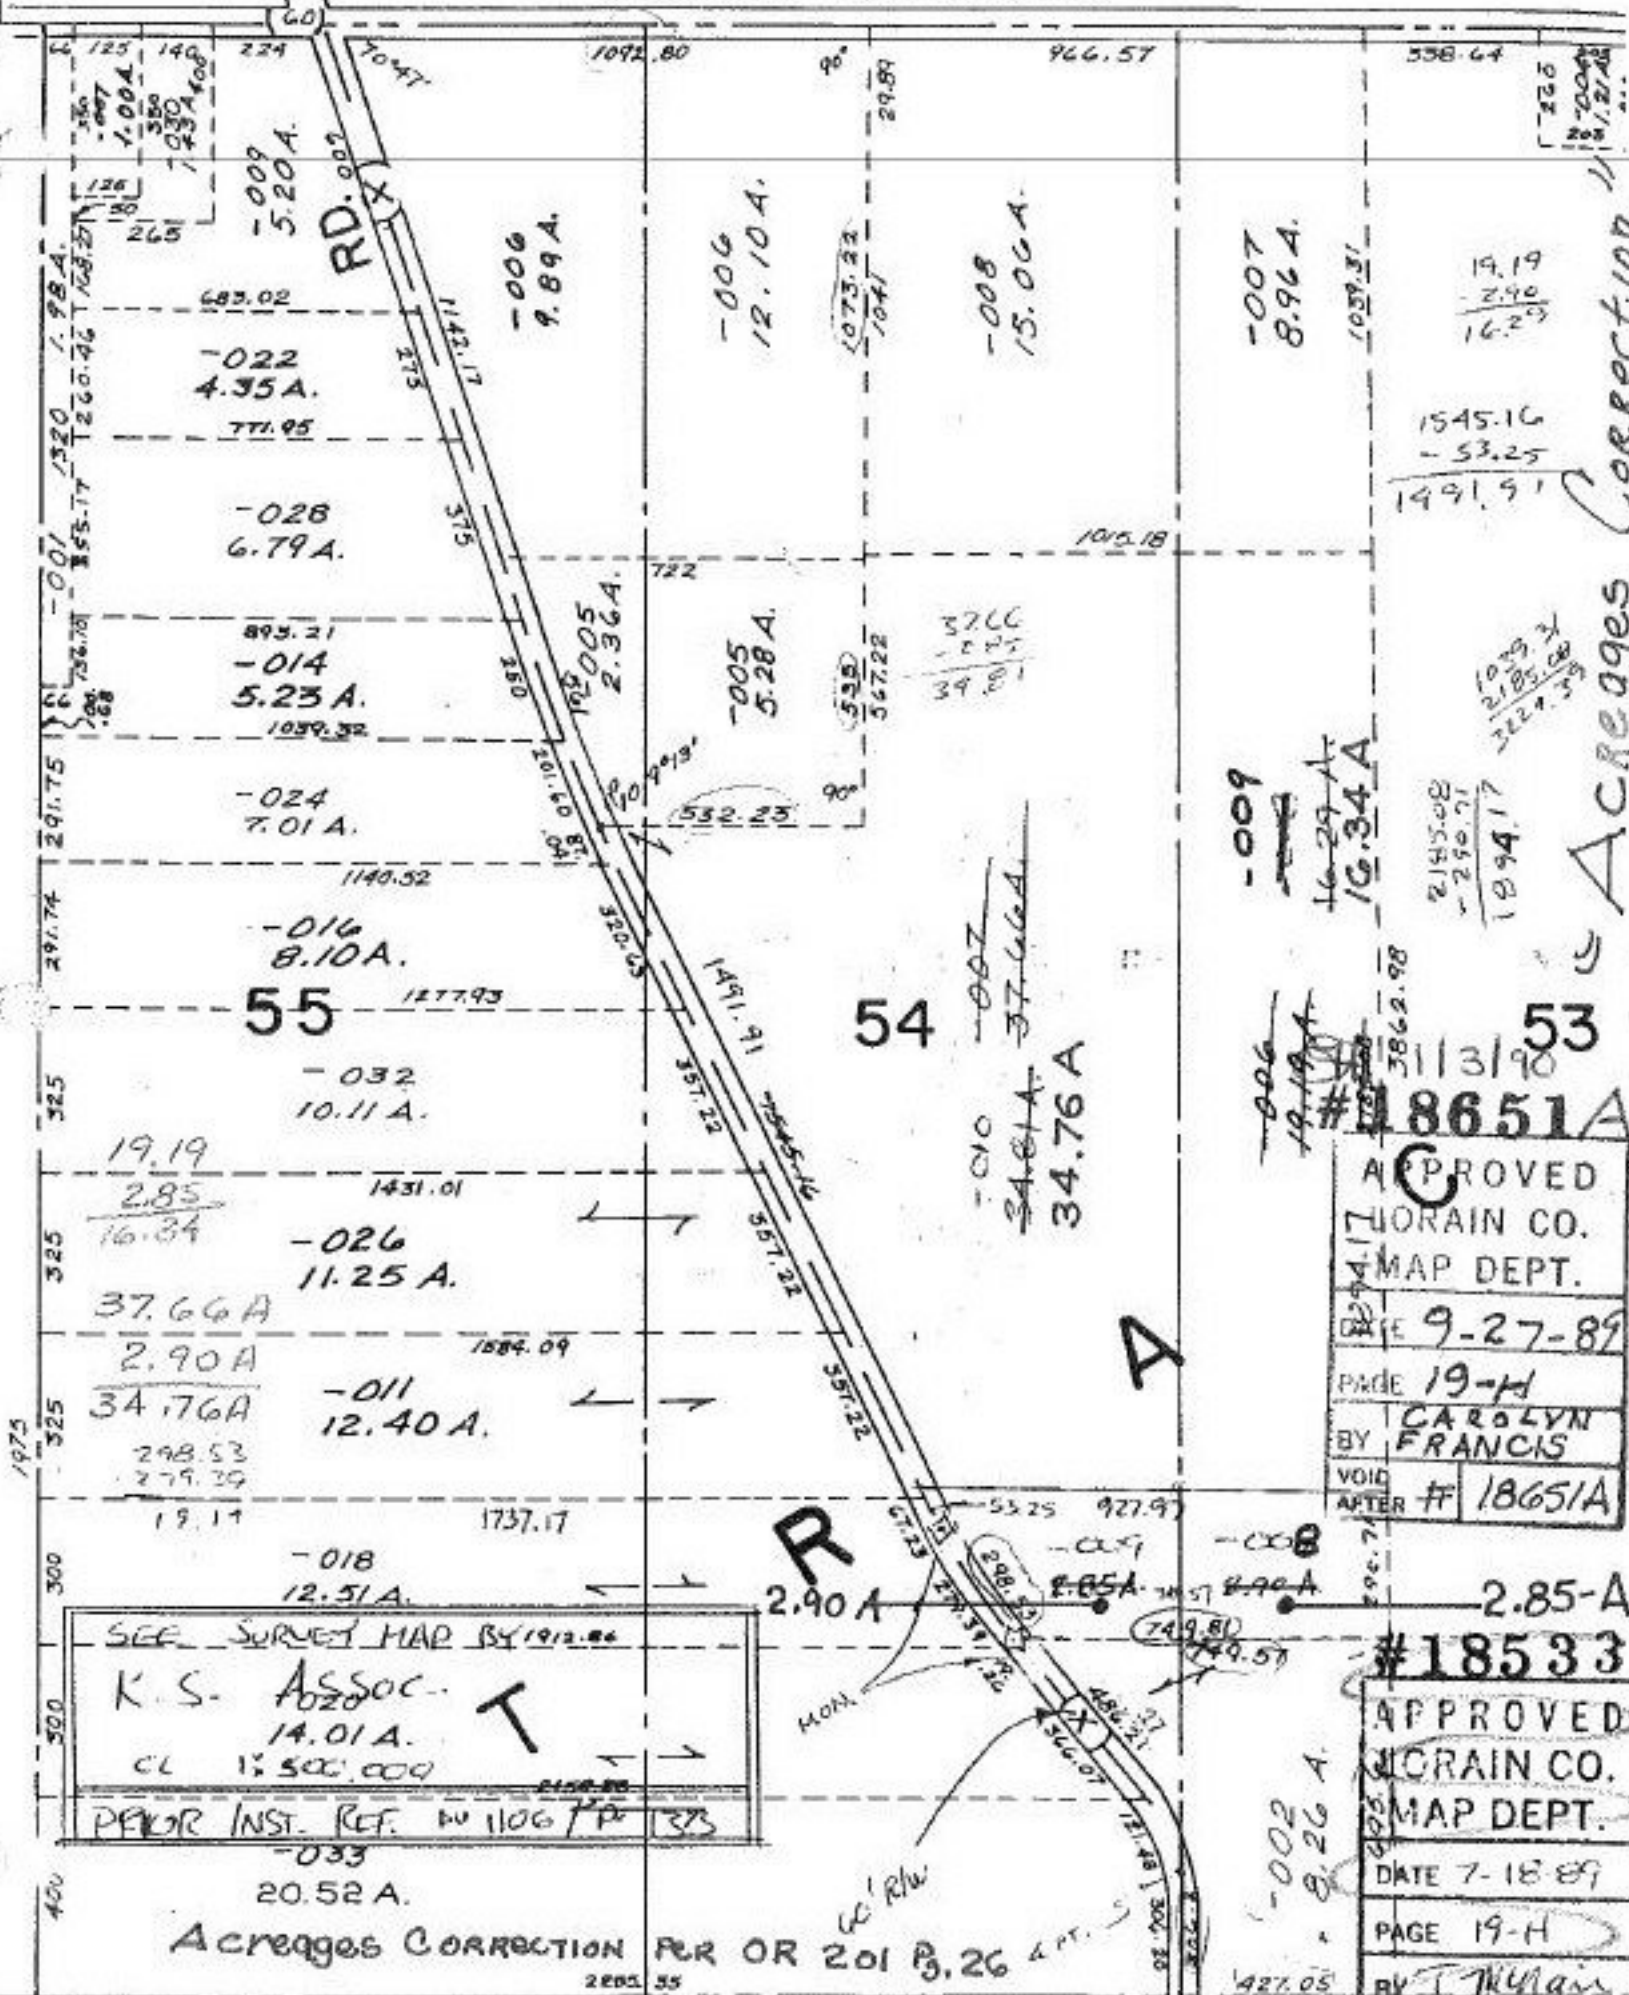

Acreages Correction

APPROVED	
MORAIN CO.	
MAP DEPT.	
DATE	9-27-89
PAGE	19-H
BY	CAROLYN FRANCIS
VOID AFTER	# 18651A

APPROVED	
MORAIN CO.	
MAP DEPT.	
DATE	7-18-89
PAGE	19-H
BY	T. Moran

Acreages Correction PER OR 201 3.26 A. PT.

SEE SURVEY MAP BY 1912.06
K.S. ASSOC.
14.01 A.
CL 1:500.000
PERIOR INST. REF. NO 1106 PP 133