

937.60
SHIFT

MOVE PAGE BREAK LINE NORTH
TO NEW PROPERTY LINE

SEE 6-77

104

Pt. -015
Pt. -012 Pt. 3.79 A.
Pt. 21.74 A.

Pt. -026
Pt. 10.03 A.

Pt. -015
Pt. 24.35 A.

TWP CITY 217.48

KEEP PAGE BREAK
LINE HERE

R=220.00
A=109.64
Ch=108.51
CB=536-25-20E

23

24

Pt. -025
Pt. 14.43 A.



109

R=264.37
A=235.45
Ch=227.77
CB=525-11-03E

Pt. -016
Pt. 12.64 A.

255.75
107.75 30 18 10
300.25
-023

592.47
0.41 A.
5.92
10
-020

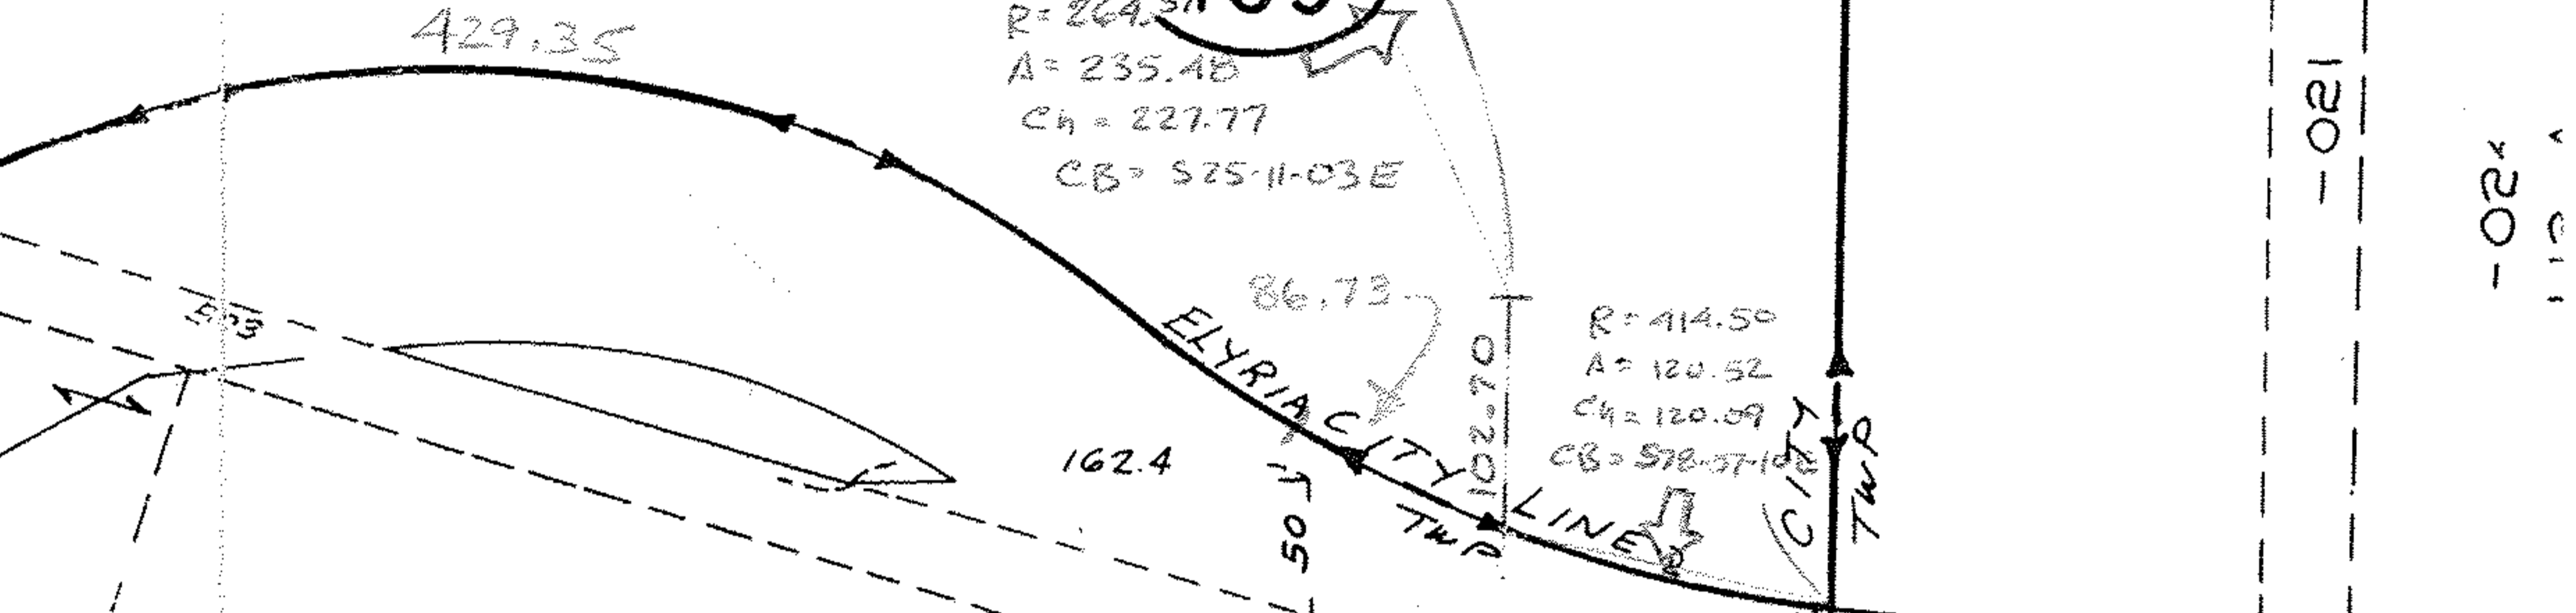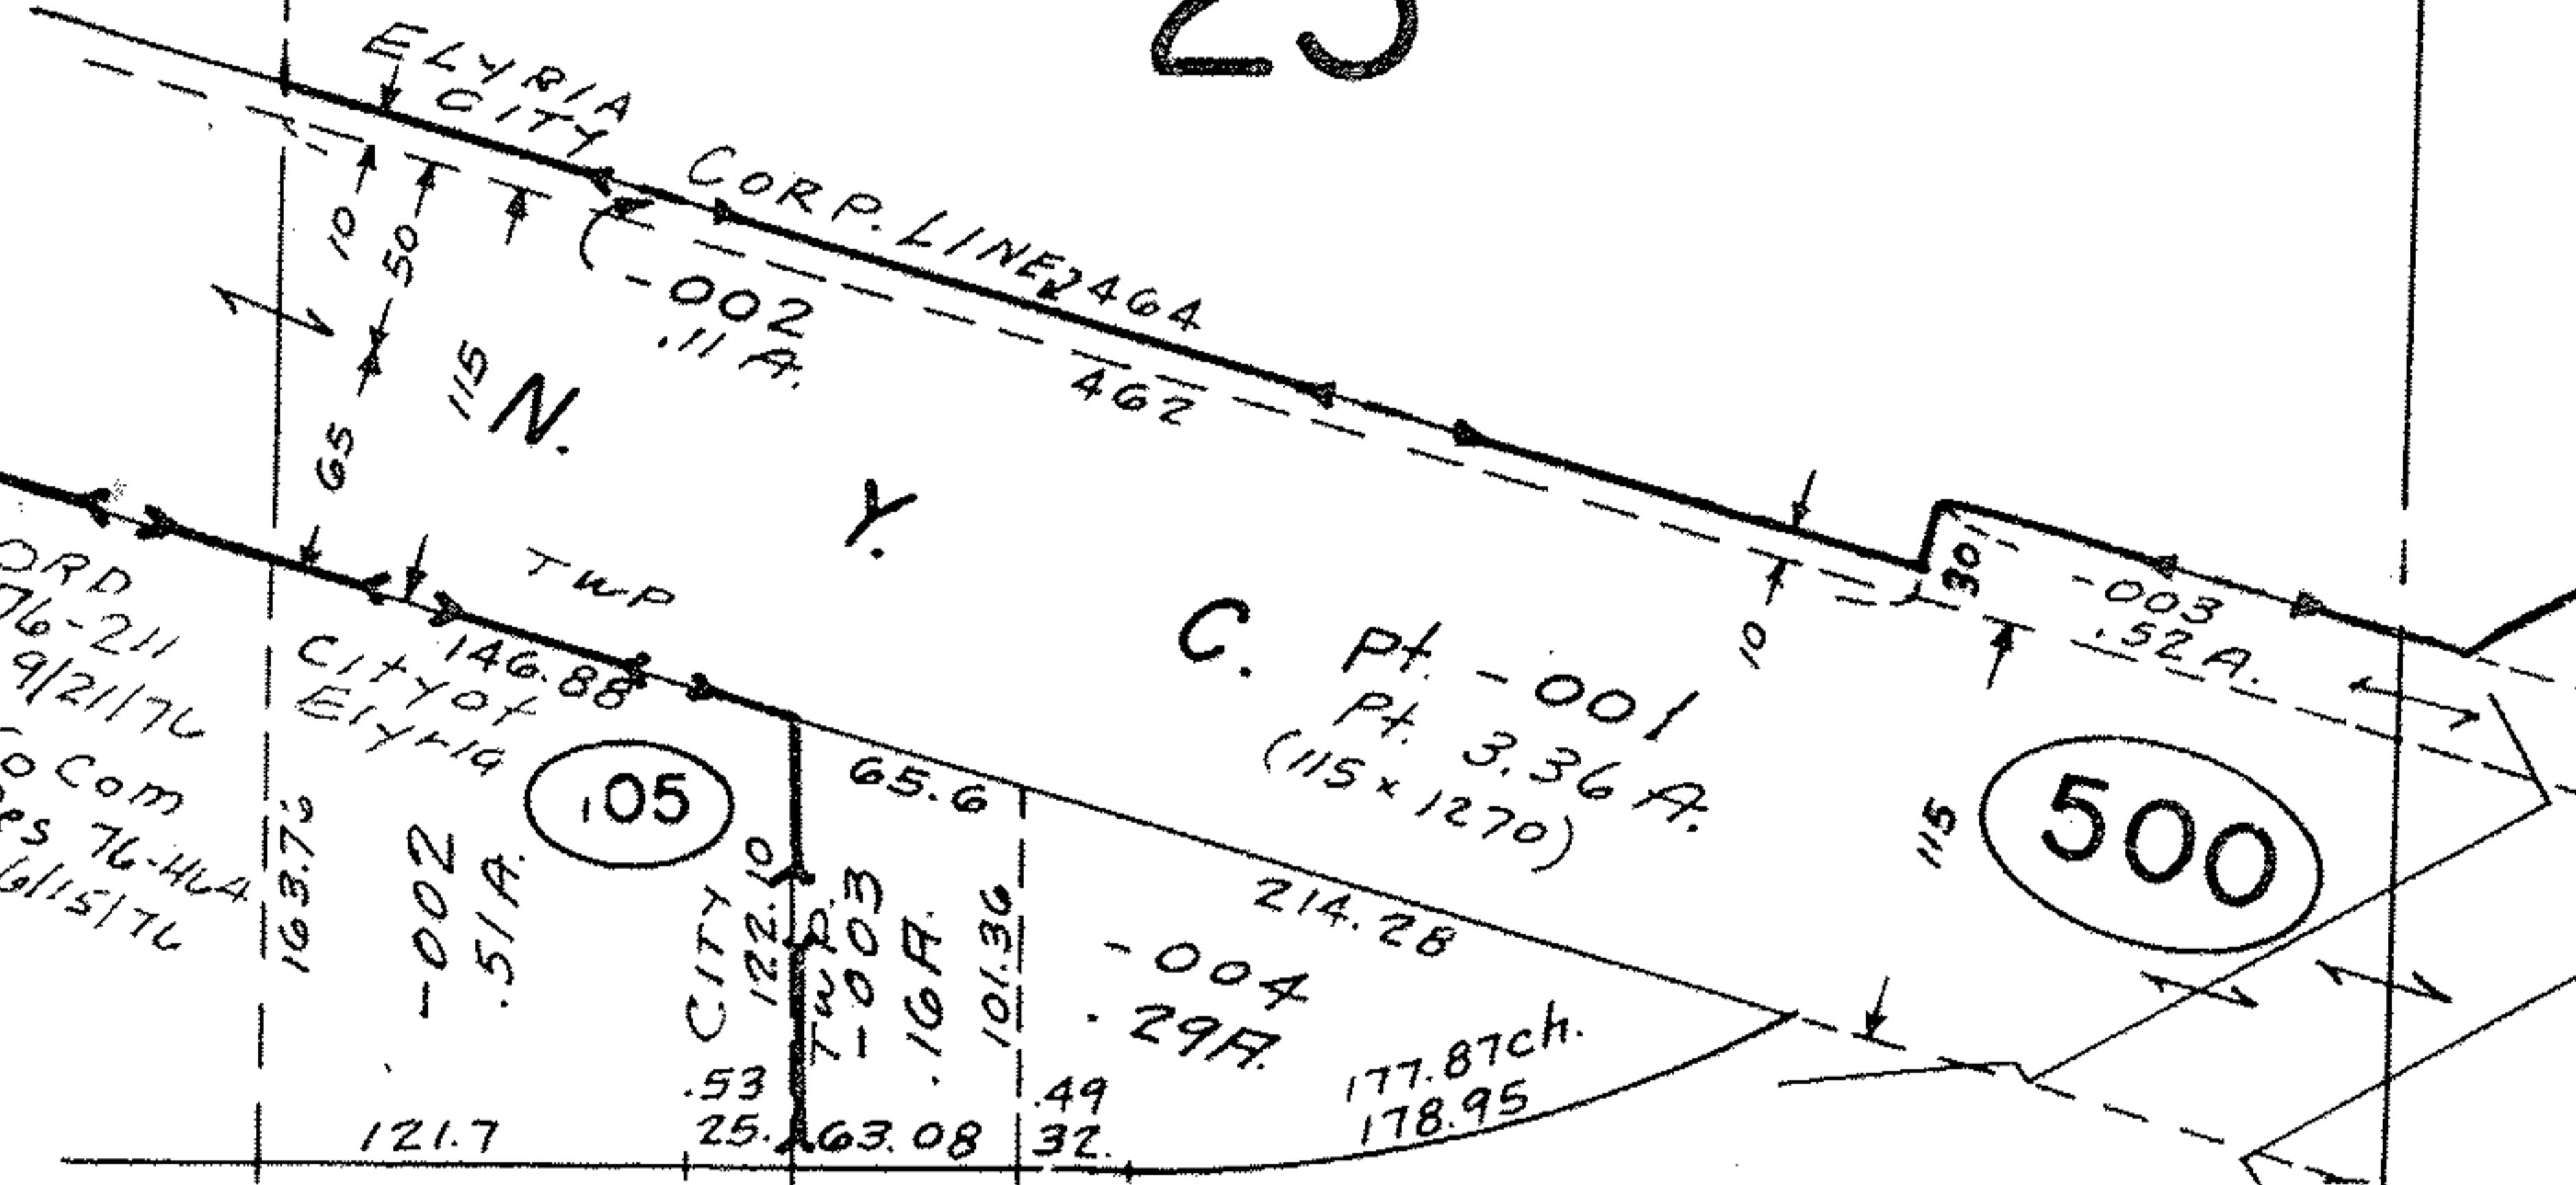

113

MILAN - ELYRIA

TWP CITY 661.81

RD. 118

5' NORTH OF R/W LINE 148

SEE SURVEY MAP BY
ZUNICH & ASSOC.
FOOR & ASSOC.
CL 1:1X106
PRIOR INST. OR 218/121

#18652

APPROVED
LORAIN CO.
MAP DEPT.
DATE 9-29-89
PAGE 6-95
BY T. McMan
VOID AFTER 18652

SEE SURVEY MAP BY
M. ZUNICH & ASSOC.
J.R. FOOR & ASSOC.
CL 1:1,000,000
OR 218/121 PRIOR INST.

10/18/89
#18652

APPROVED
LORAIN CO.
MAP DEPT.
DATE 9-29-89
PAGE 6-95
BY T. McMan
VOID AFTER 18652

