


ROBERT J. & LENORA CRITES

Vol. 382 Pg. 486

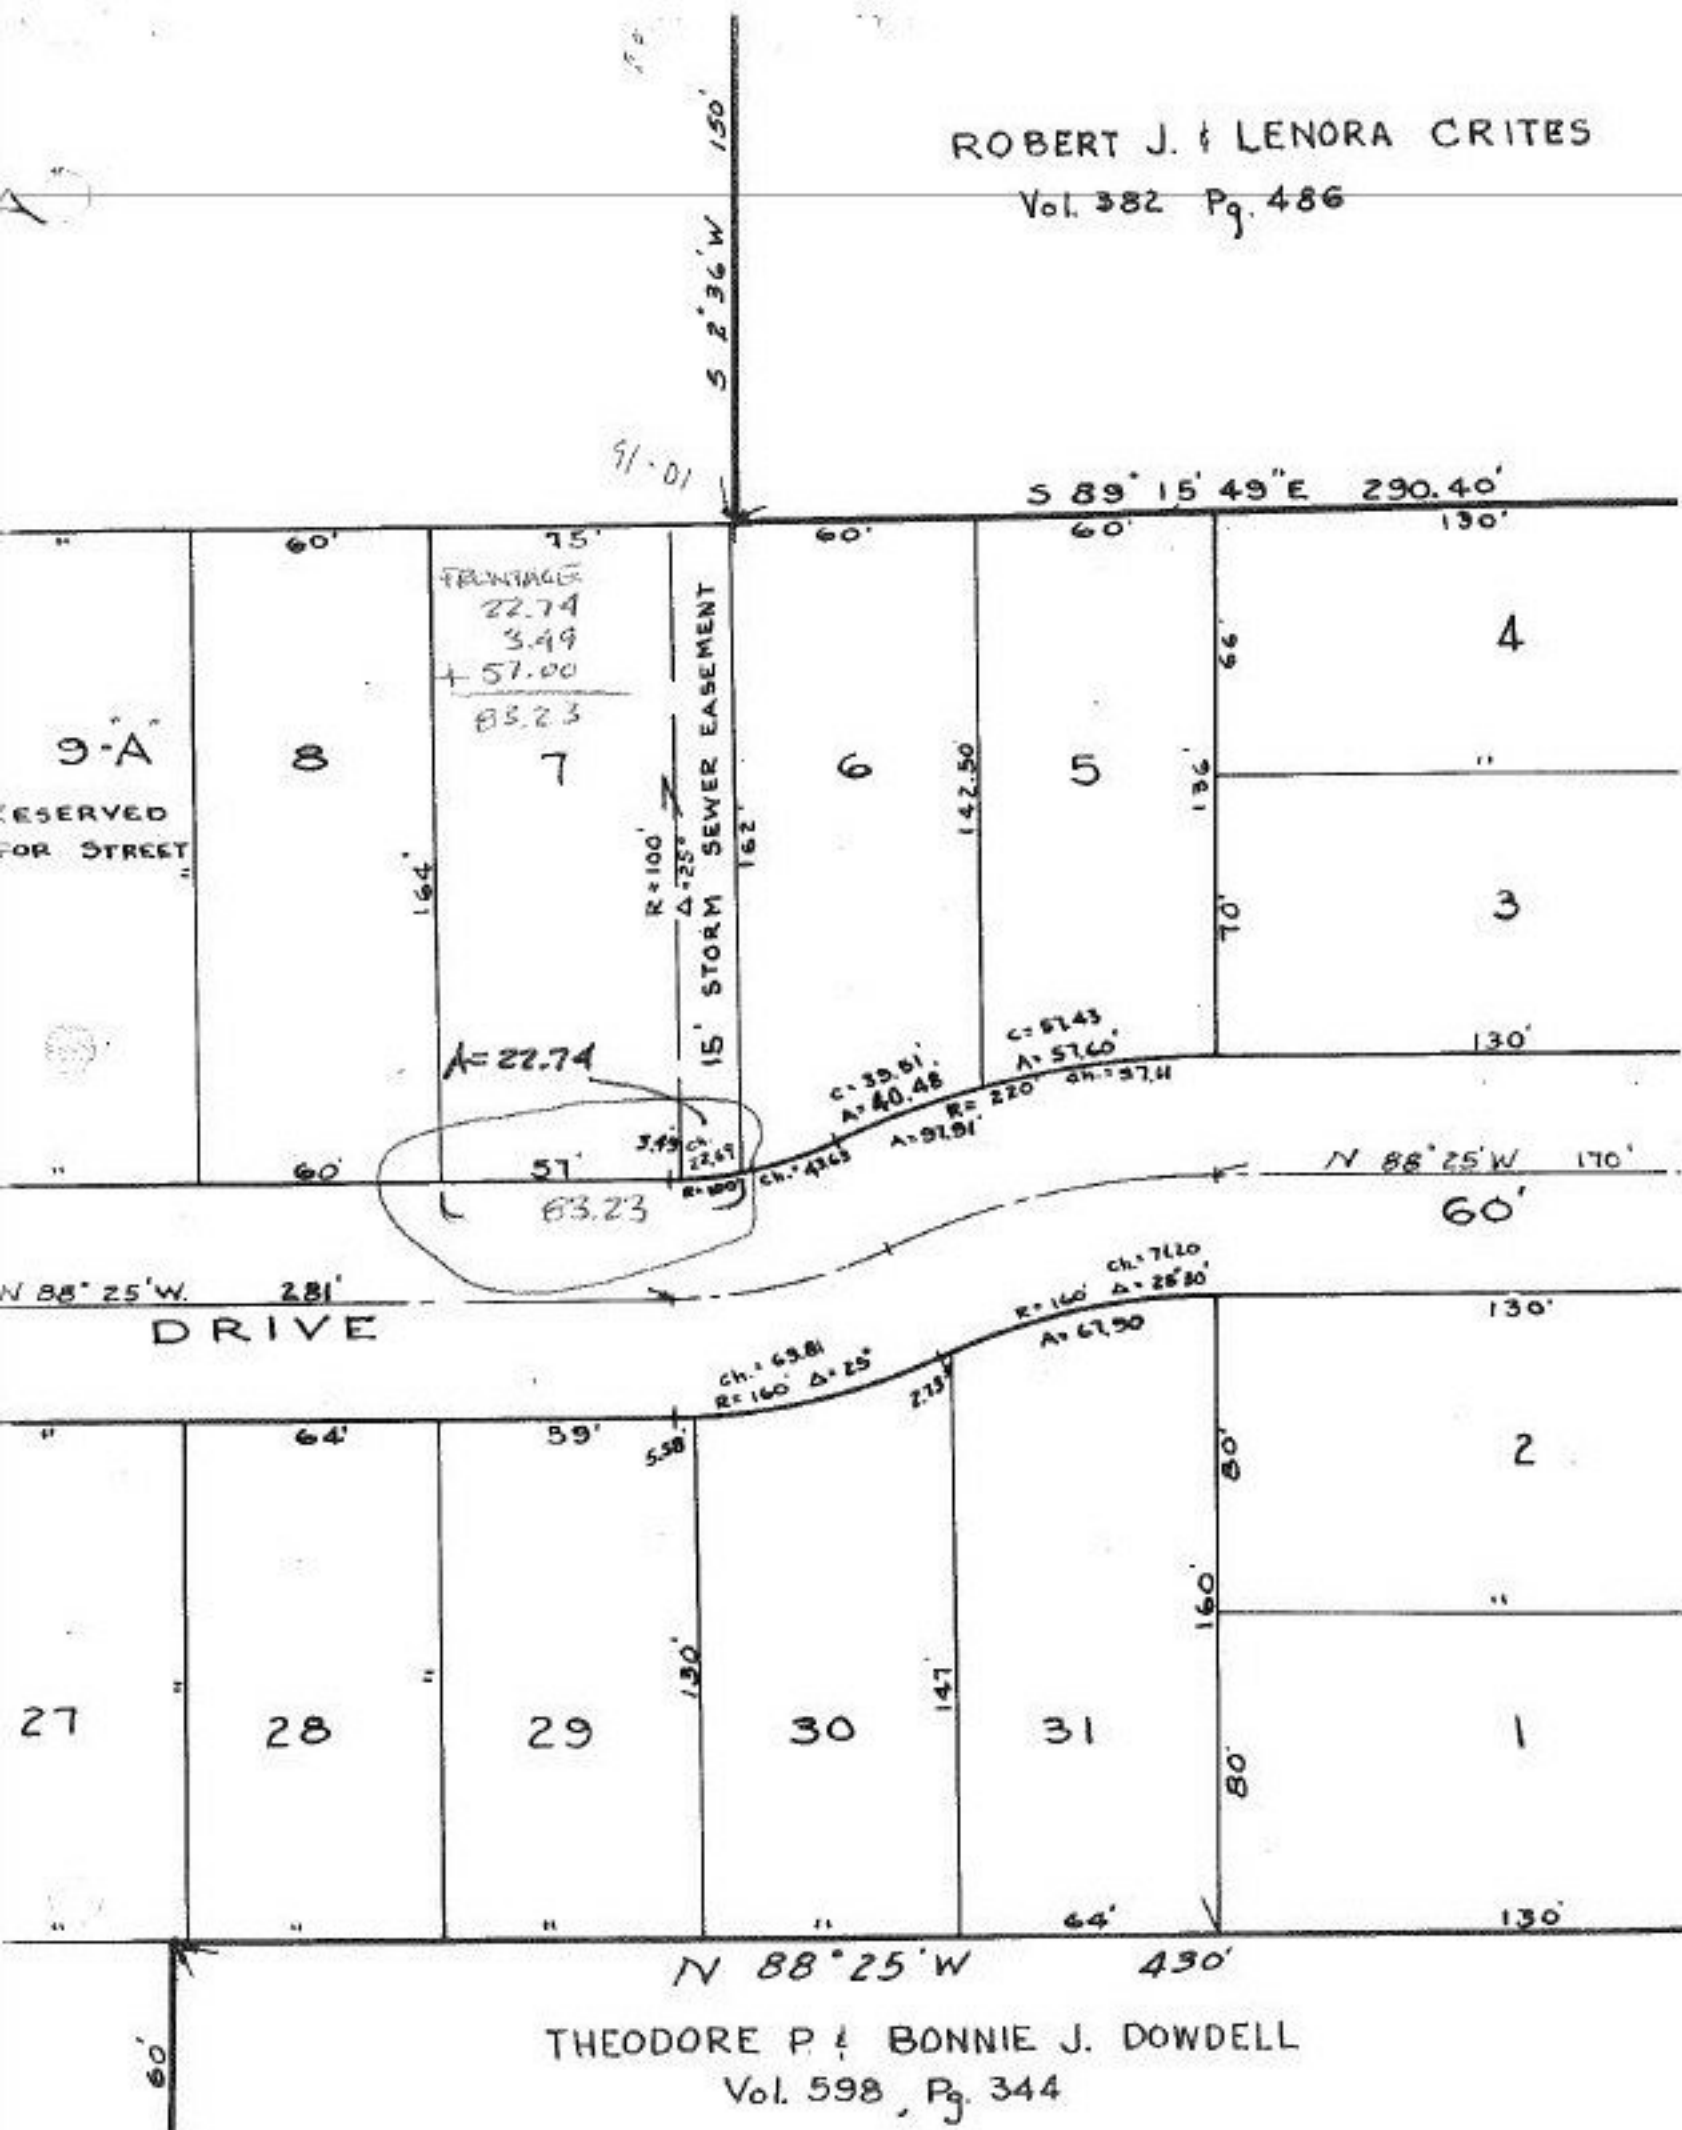

FRONTAGE  
 22.74  
 3.49  
 + 57.00  
 -----  
 83.23

A=22.74

57  
 83.23

15' STORM SEWER EASEMENT

R=100  
 Δ=25°

C=39.81  
 A=40.48  
 R=220  
 Δ=97.91'

C=57.43  
 A=57.60  
 Δ=57.4

Ch=63.81  
 R=160  
 Δ=25°

Ch=71.20  
 R=160  
 Δ=25°  
 A=67.50

DRIVE

THEODORE P. & BONNIE J. DOWDELL  
 Vol. 598, Pg. 344