
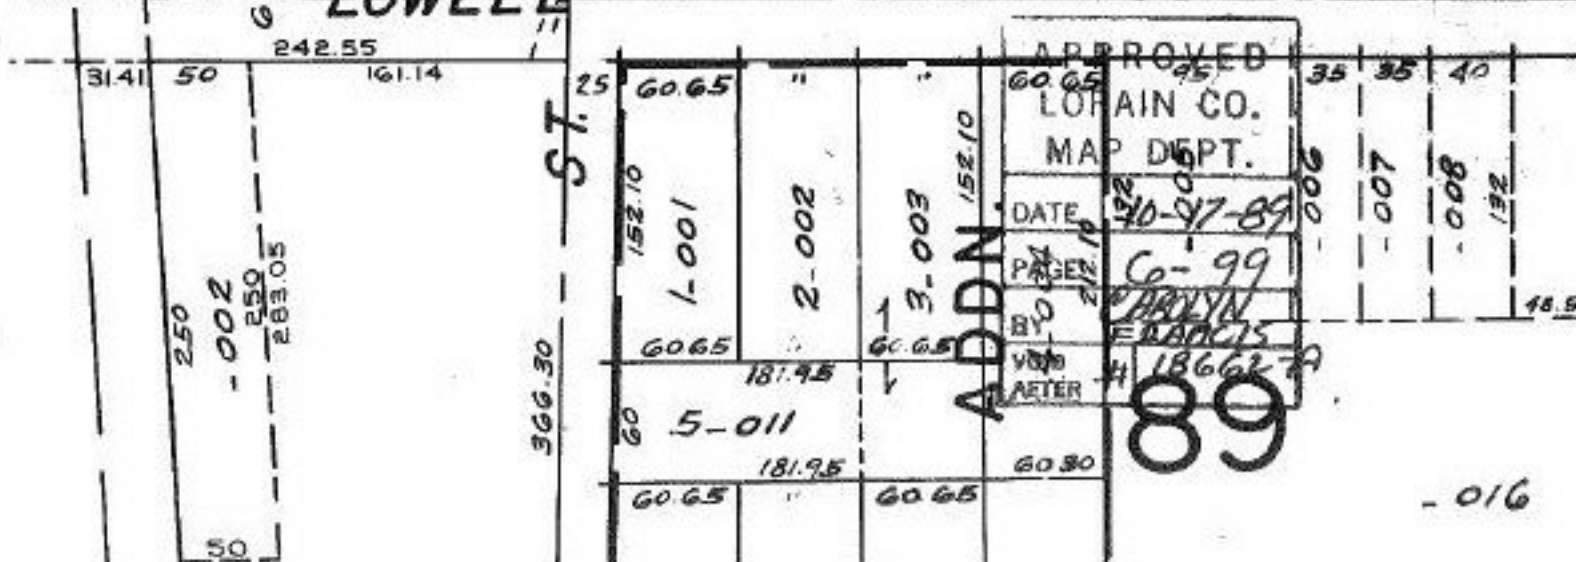


SEE 6-8
BATH

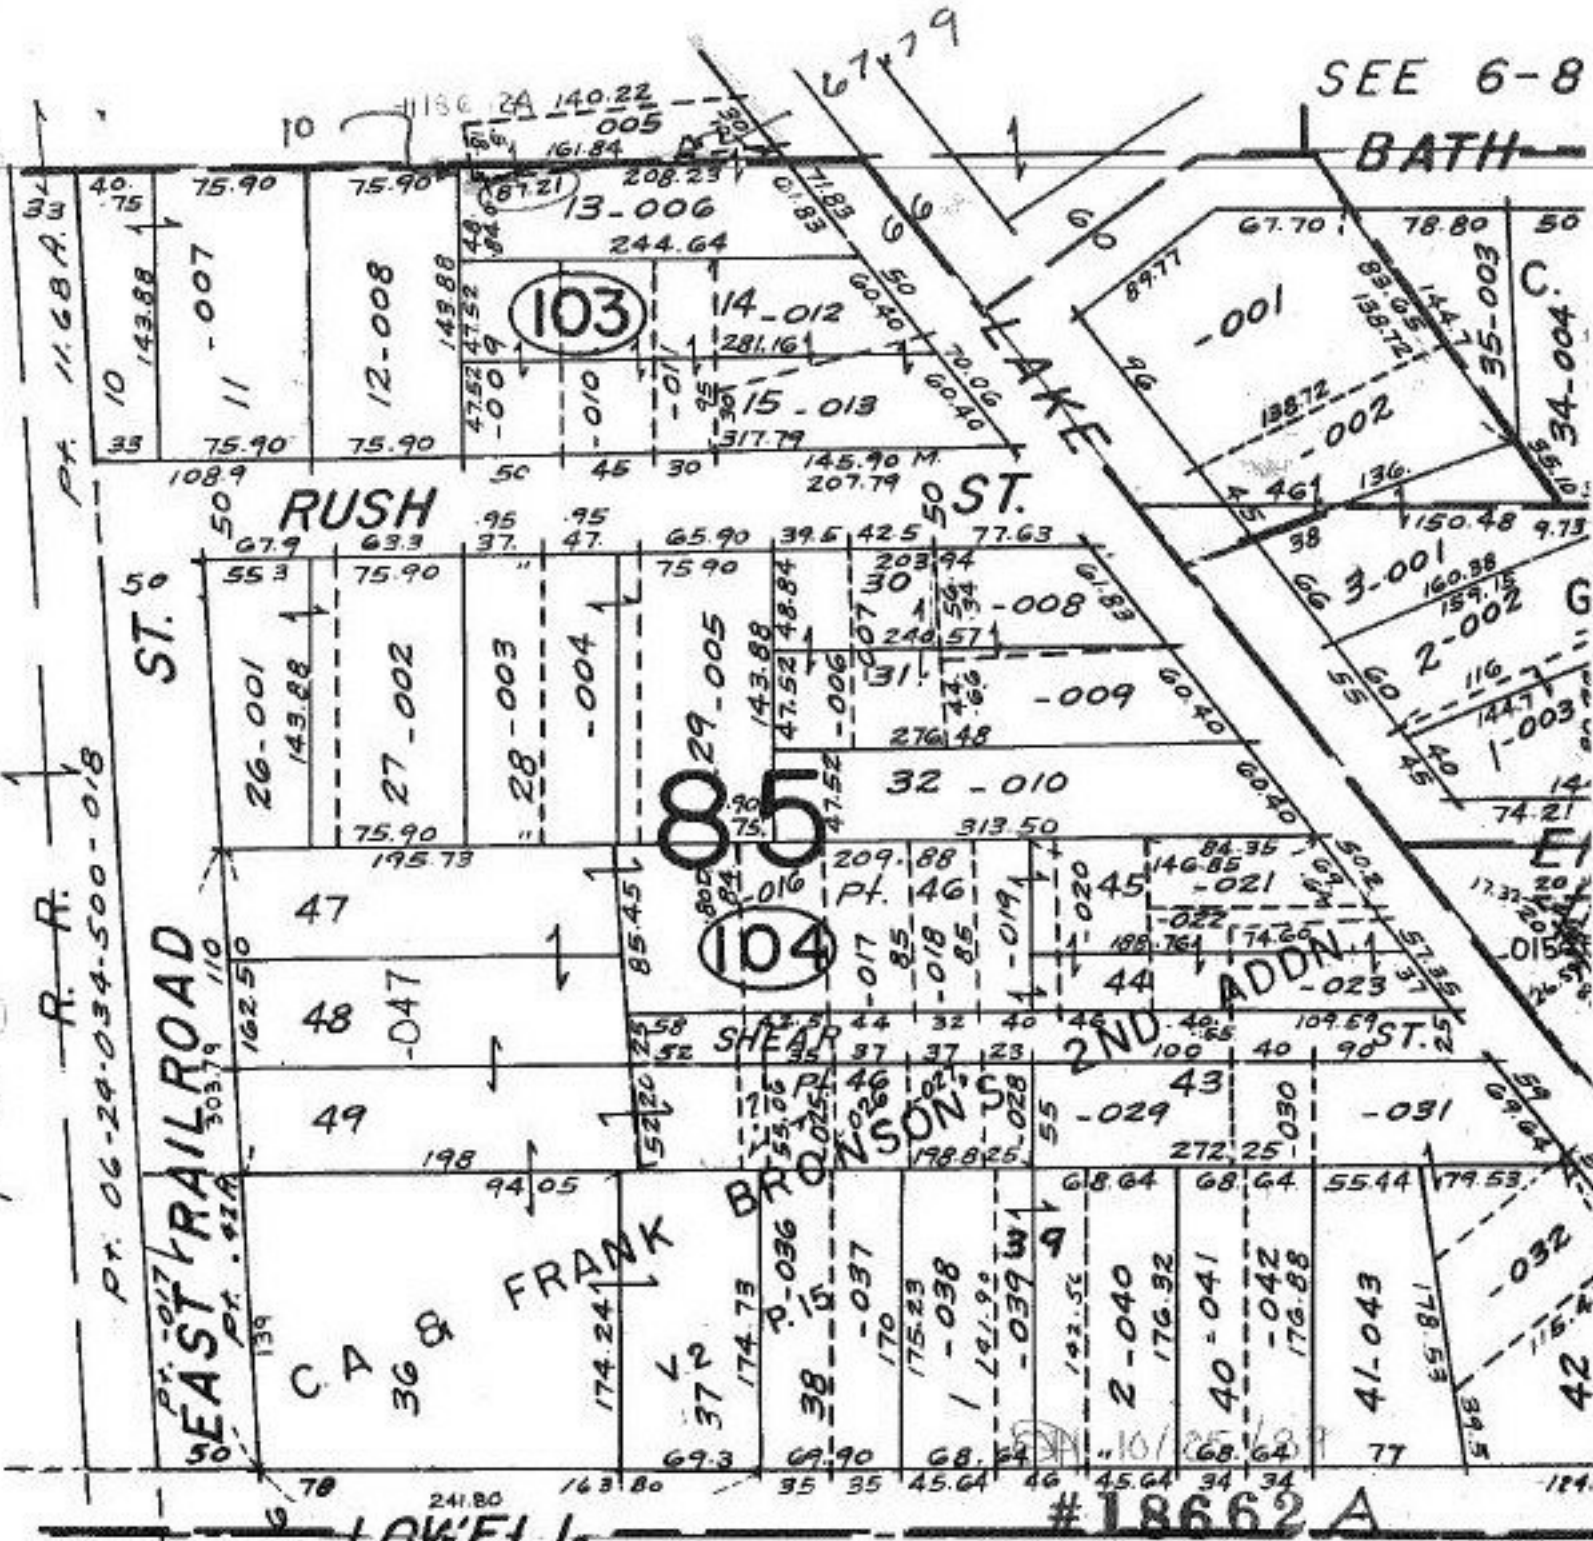

APPROVED
 LORAIN CO.
 MAP DEPT.
 DATE 10-27-89
 BY CHARLYN FRANCIS
 V. BY #186627A
 AFTER

89

- 016