

44.62  
0.95  
45.57

Pt. -034  
Pt. 47.56 A.

Pt. -036

Pt. ~~44.62 A.~~


46.61 A

AC. CORR

"Ac. CORR."

AC. WAS SUBTRACTED FROM ACREAGES  
ON TRANSFER SHEET ACREAGES WAS WRONG.  
AC ON TRANSFER SHEET DATED \_\_\_\_\_ NO.  
WAS 45.57 A. SHOULD HAVE BEEN  
47.56 A.

AC. CORR.

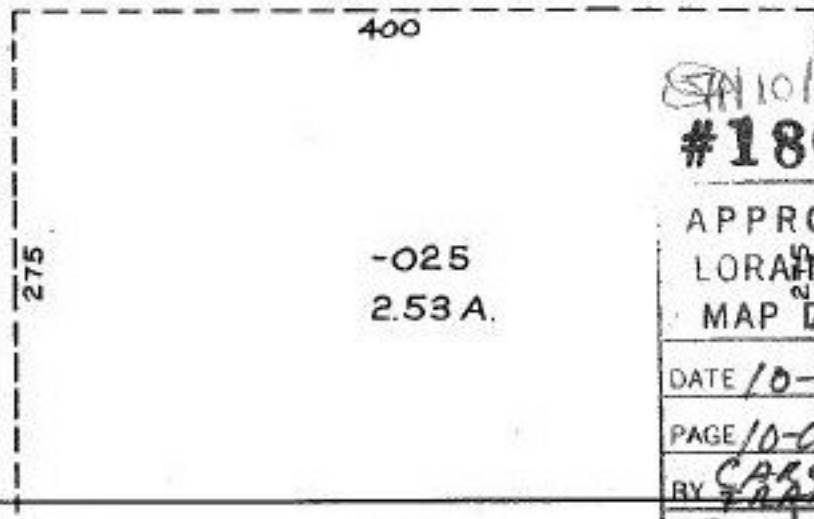

SN 10/27/89  
#18675A

APPROVED  
LORAIN CO.  
MAP DEPT.

DATE 10-16-89

PAGE 10-01-015-H

BY CAROLYN FRANCIS

VOID AFTER # 18675A

ROBSON

SN 9/12/88  
#17971

APPROVED  
LORAIN CO.  
MAP DEPT.

DATE 6-2-83

PAGE 10-01-015-H

BY CAROL FRANCIS

VOID AFTER # 17971

116

Pt. -020  
Pt. 16.86 A.