

Pt. -034
Pt. 47.56 A.


- 036
44.62 A
46.61 A AC. CORR.

AC. WAS SUBTRACTED FROM AC REAGES
ON TRANSFER SHEET AC. WAS WRONG,
AC ON TRANSFER SHEET DATED 6-17-88 No. 8
WAS 45.57 A SHOULD HAVE BEEN
47.56 A

AC. CORR

SA 10/27/87

#18675 A

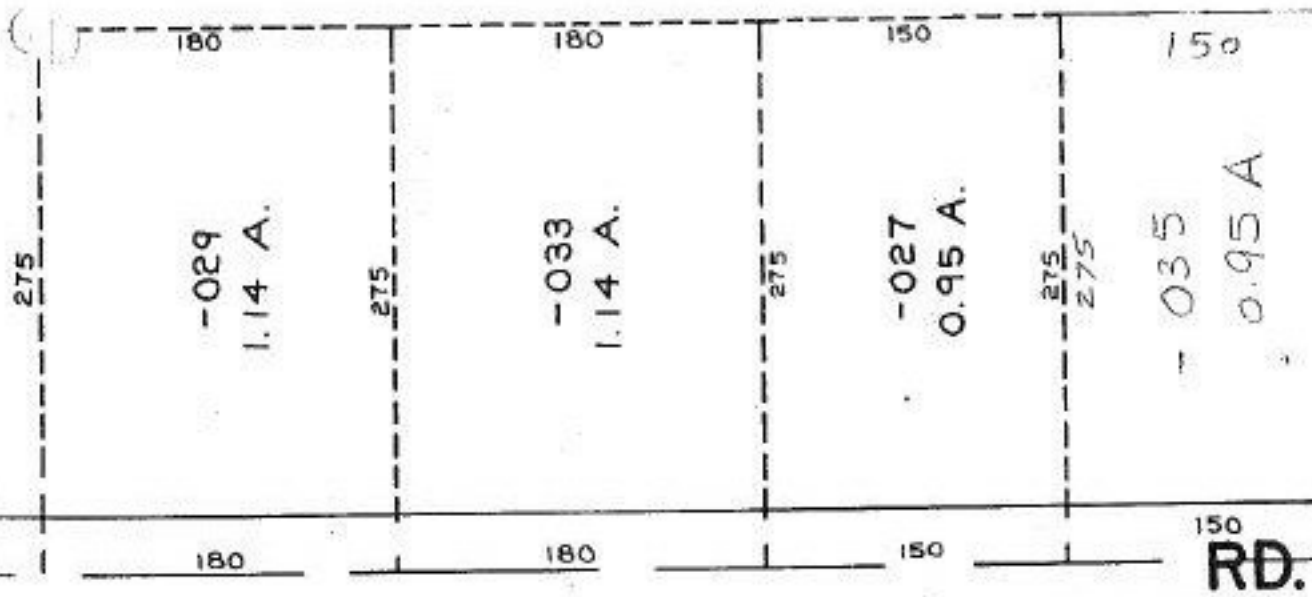

APPROVED	
LORAIN CO.	
MAP DEPT.	
DATE	10-16-89
PAGE	10-00-015-G
BY	CAROL FRANCIS
VOID AFTER	#18675

SA 9/12/88

To 1290

#17971

10-00-015-116
749-525
Prior Deed 1100-35
Map by Arnold Koepf - Reg. Surveyor

10-00-015-G

APPROVED	
LORAIN CO.	
MAP DEPT.	
DATE	2-88
PAGE	10-00-015-G
BY	AROLD FRANCIS
VOID AFTER	#17971

Pt. -020
Pt. 16.86 A.