


SEE SURVEY MAP BY  
 JOHN POZYWANK  
 et. al. 1: ICG, 6CC  
 PRIOR INST. # 309/457 OR  
 194/484

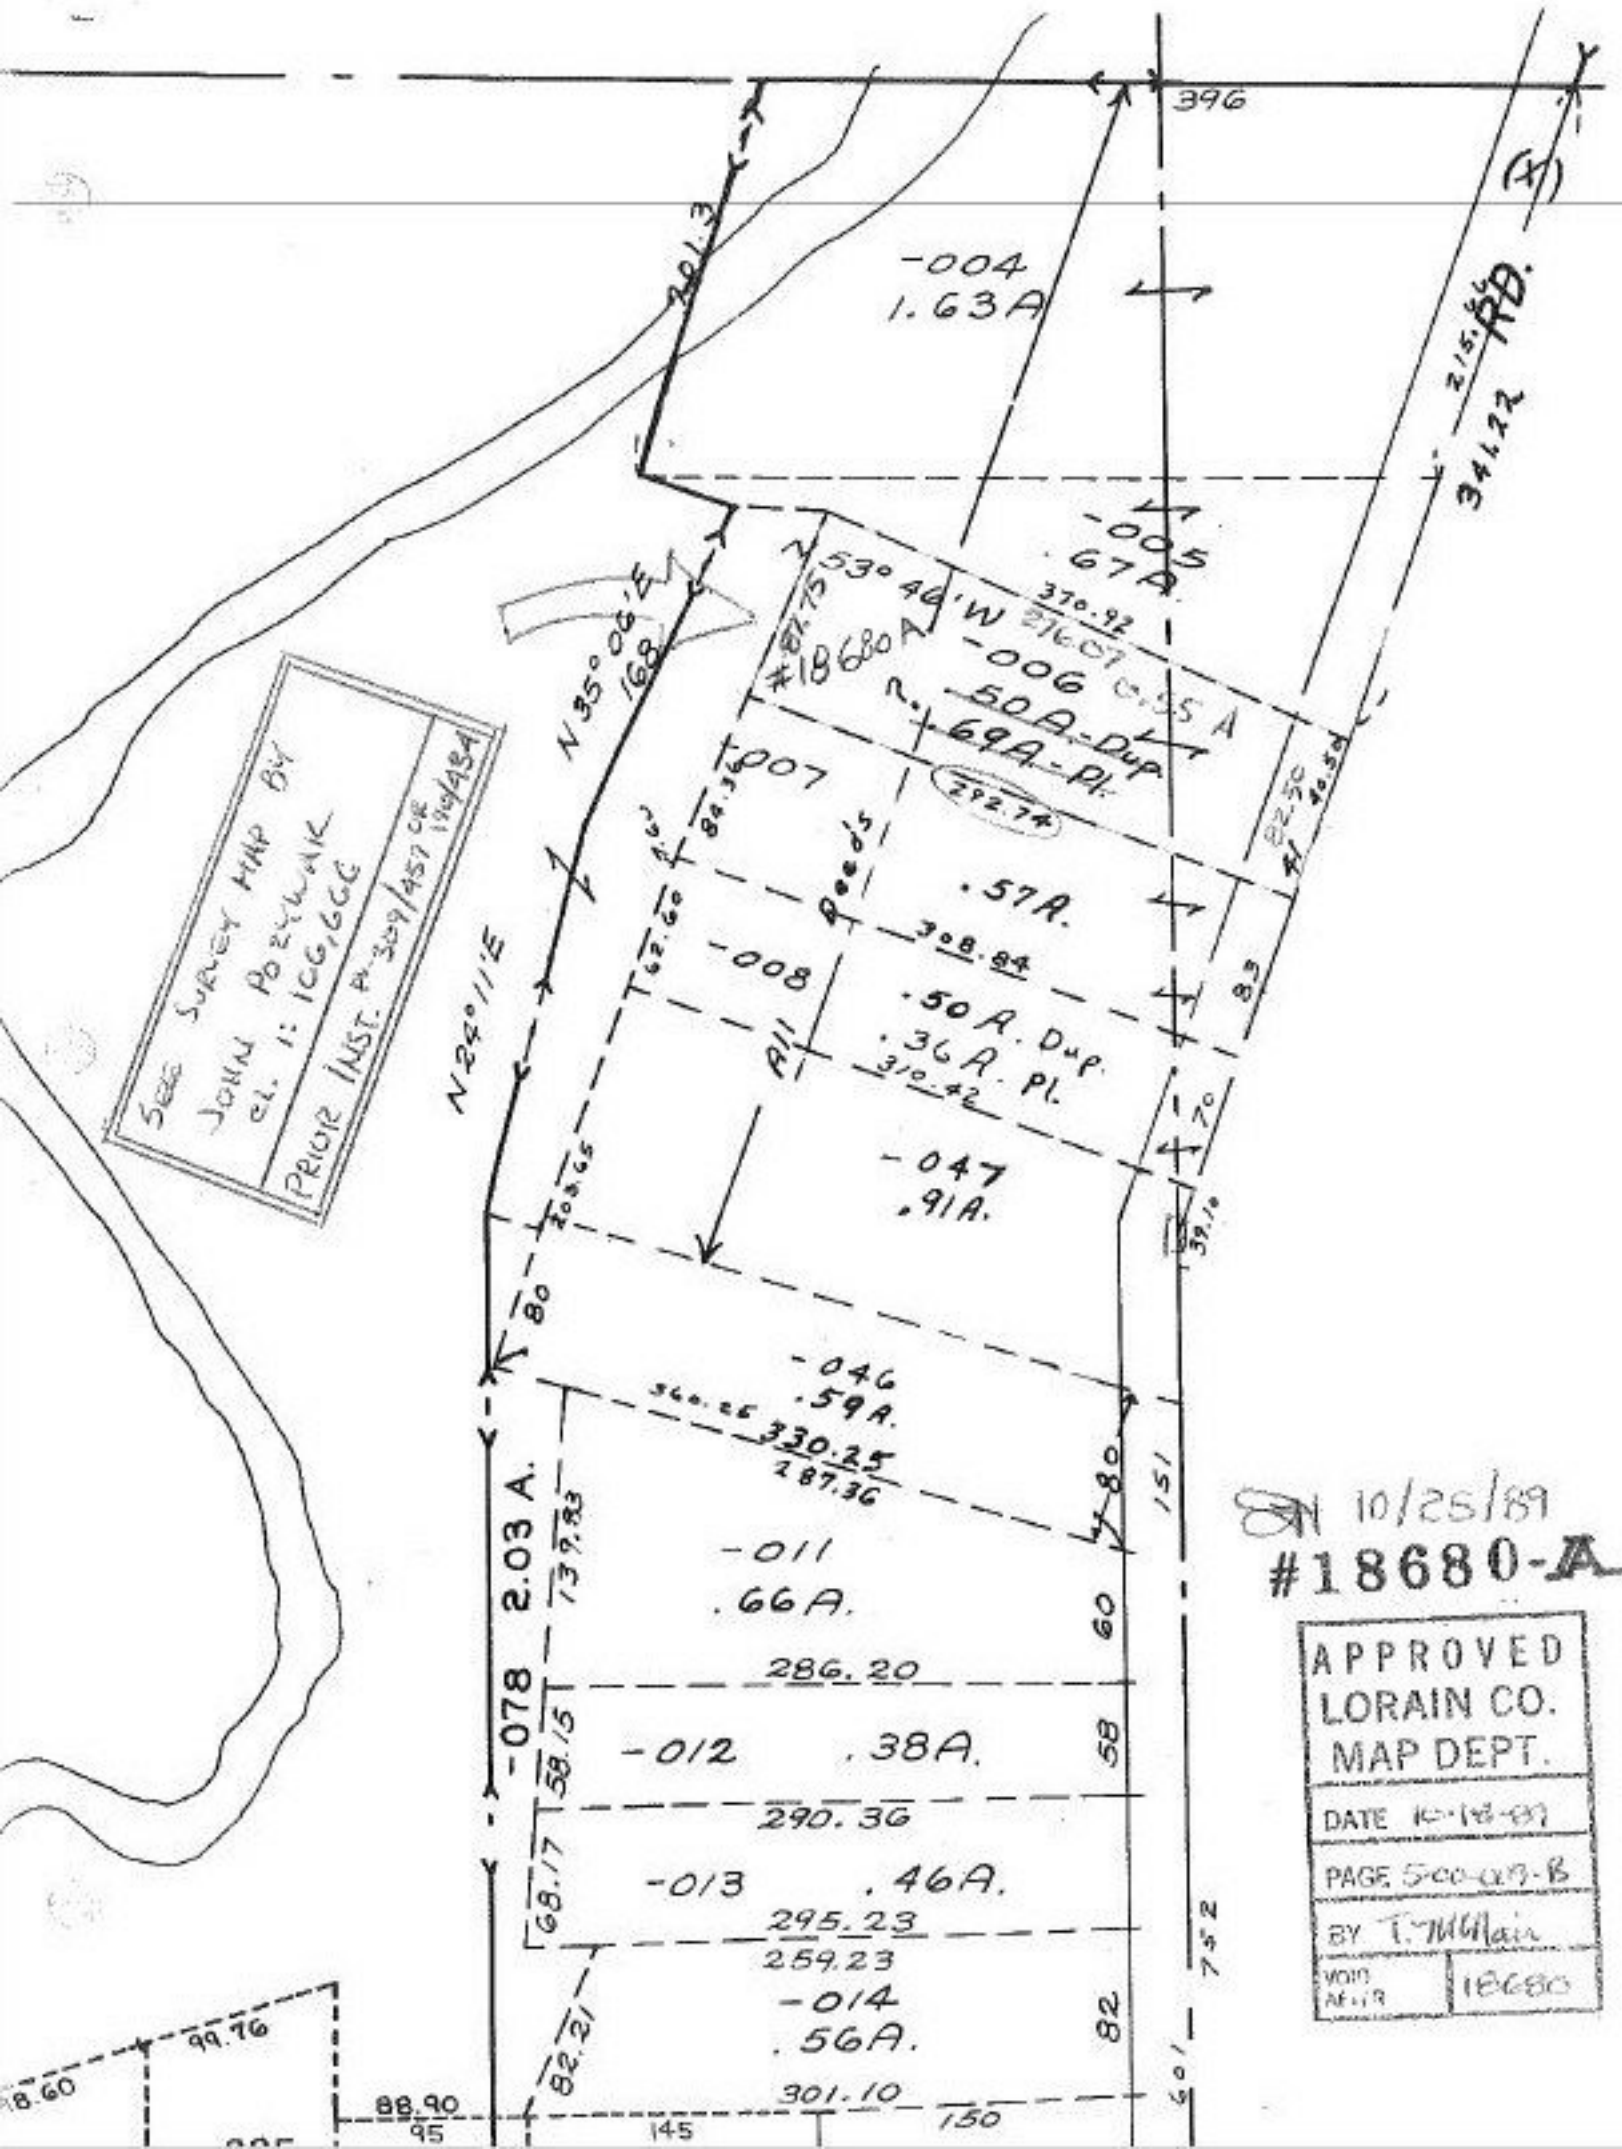

10/25/89  
 #18680-A

|                                     |       |
|-------------------------------------|-------|
| APPROVED<br>LORAIN CO.<br>MAP DEPT. |       |
| DATE 10-18-89                       |       |
| PAGE 500-09-B                       |       |
| BY T. McHain                        |       |
| VOID<br>AF 1/9                      | 18680 |