


K.D.

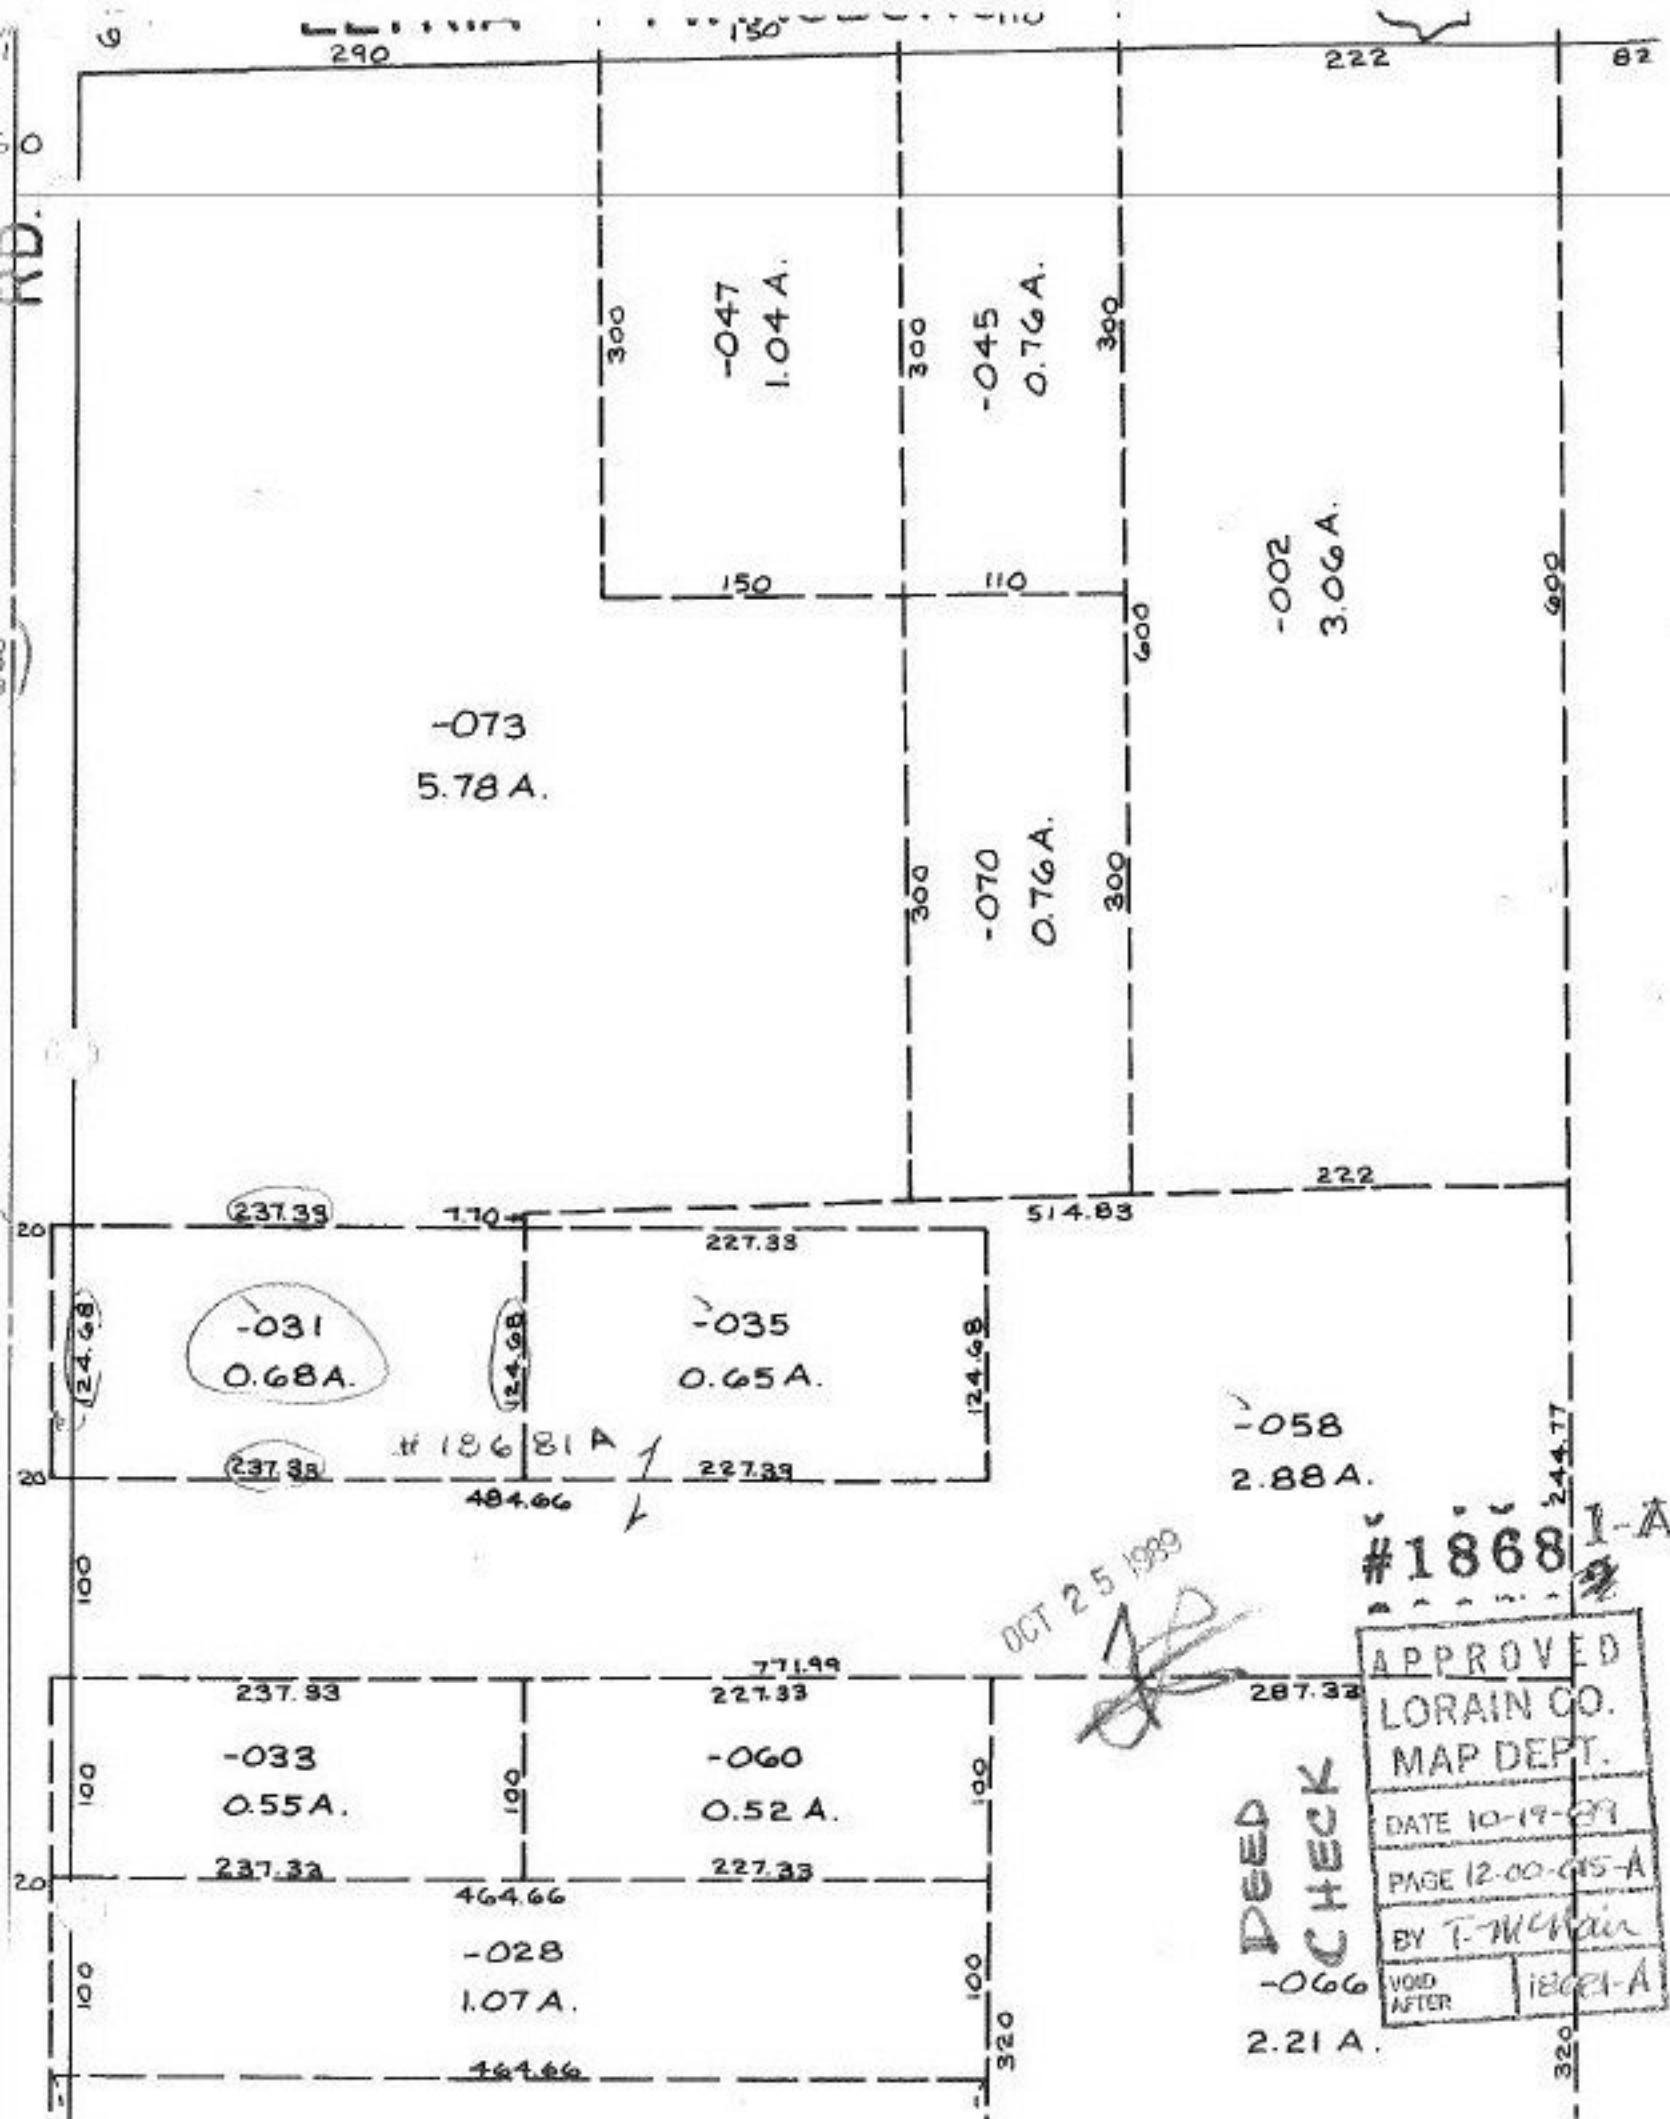

OCT 25 1989

#1868-1-A

DEED CHECK

APPROVED	
LORAIN CO. MAP DEPT.	
DATE 10-19-89	
PAGE 12-00-015-A	
BY T. McWain	
VOID AFTER	1868-1-A

-066
2.21 A.