


MON. BOX FOUND INTERSECTION OF ALBRECHT & BECHTEL RD ALBRECHT RD

323.45

MON. BOX RD

(50-60-?)

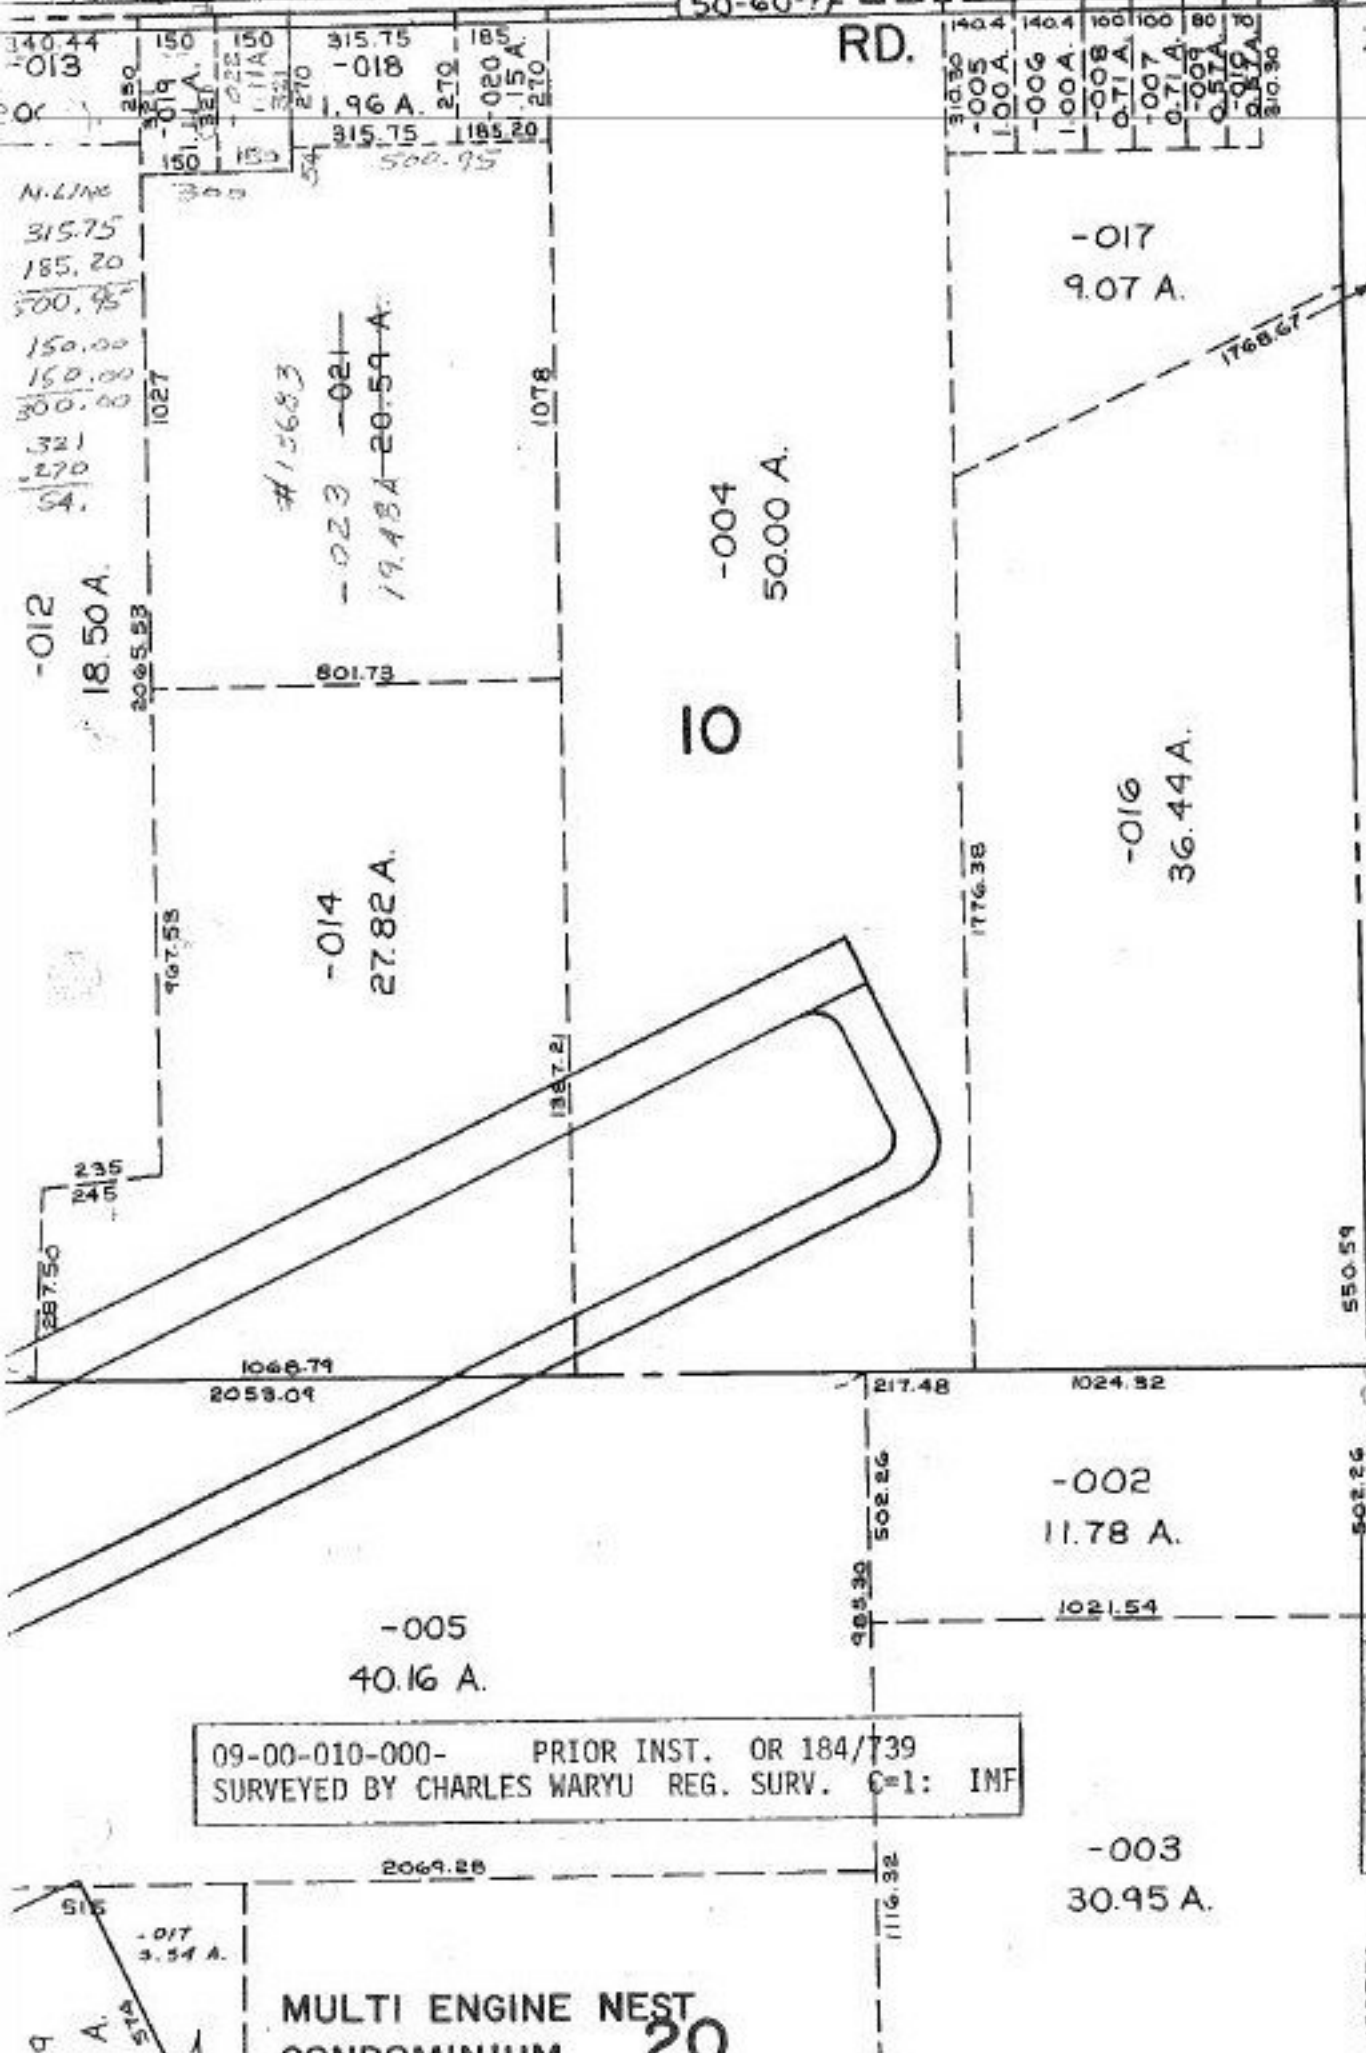

-021 20.59
SPILT 1.11
REM. 19.48

09-00-010-000- PRIOR INST. OR 184/739
SURVEYED BY CHARLES WARYU REG. SURV. C=1: IMF

11/13/89
#18689
 APPROVED
 LORAIN CO.
 MAP DEPT.
 DATE 10-19-89
 PAGE 9-D
 BY CAROLYN FRANCIS
 VOID AFTER # 18683

MULTI ENGINE NEST
CONDOMINIUM 20