


MON. LOCATED SEE 3-00-211-B
 + ABBE RD & S.L.O.L.I 1305.35

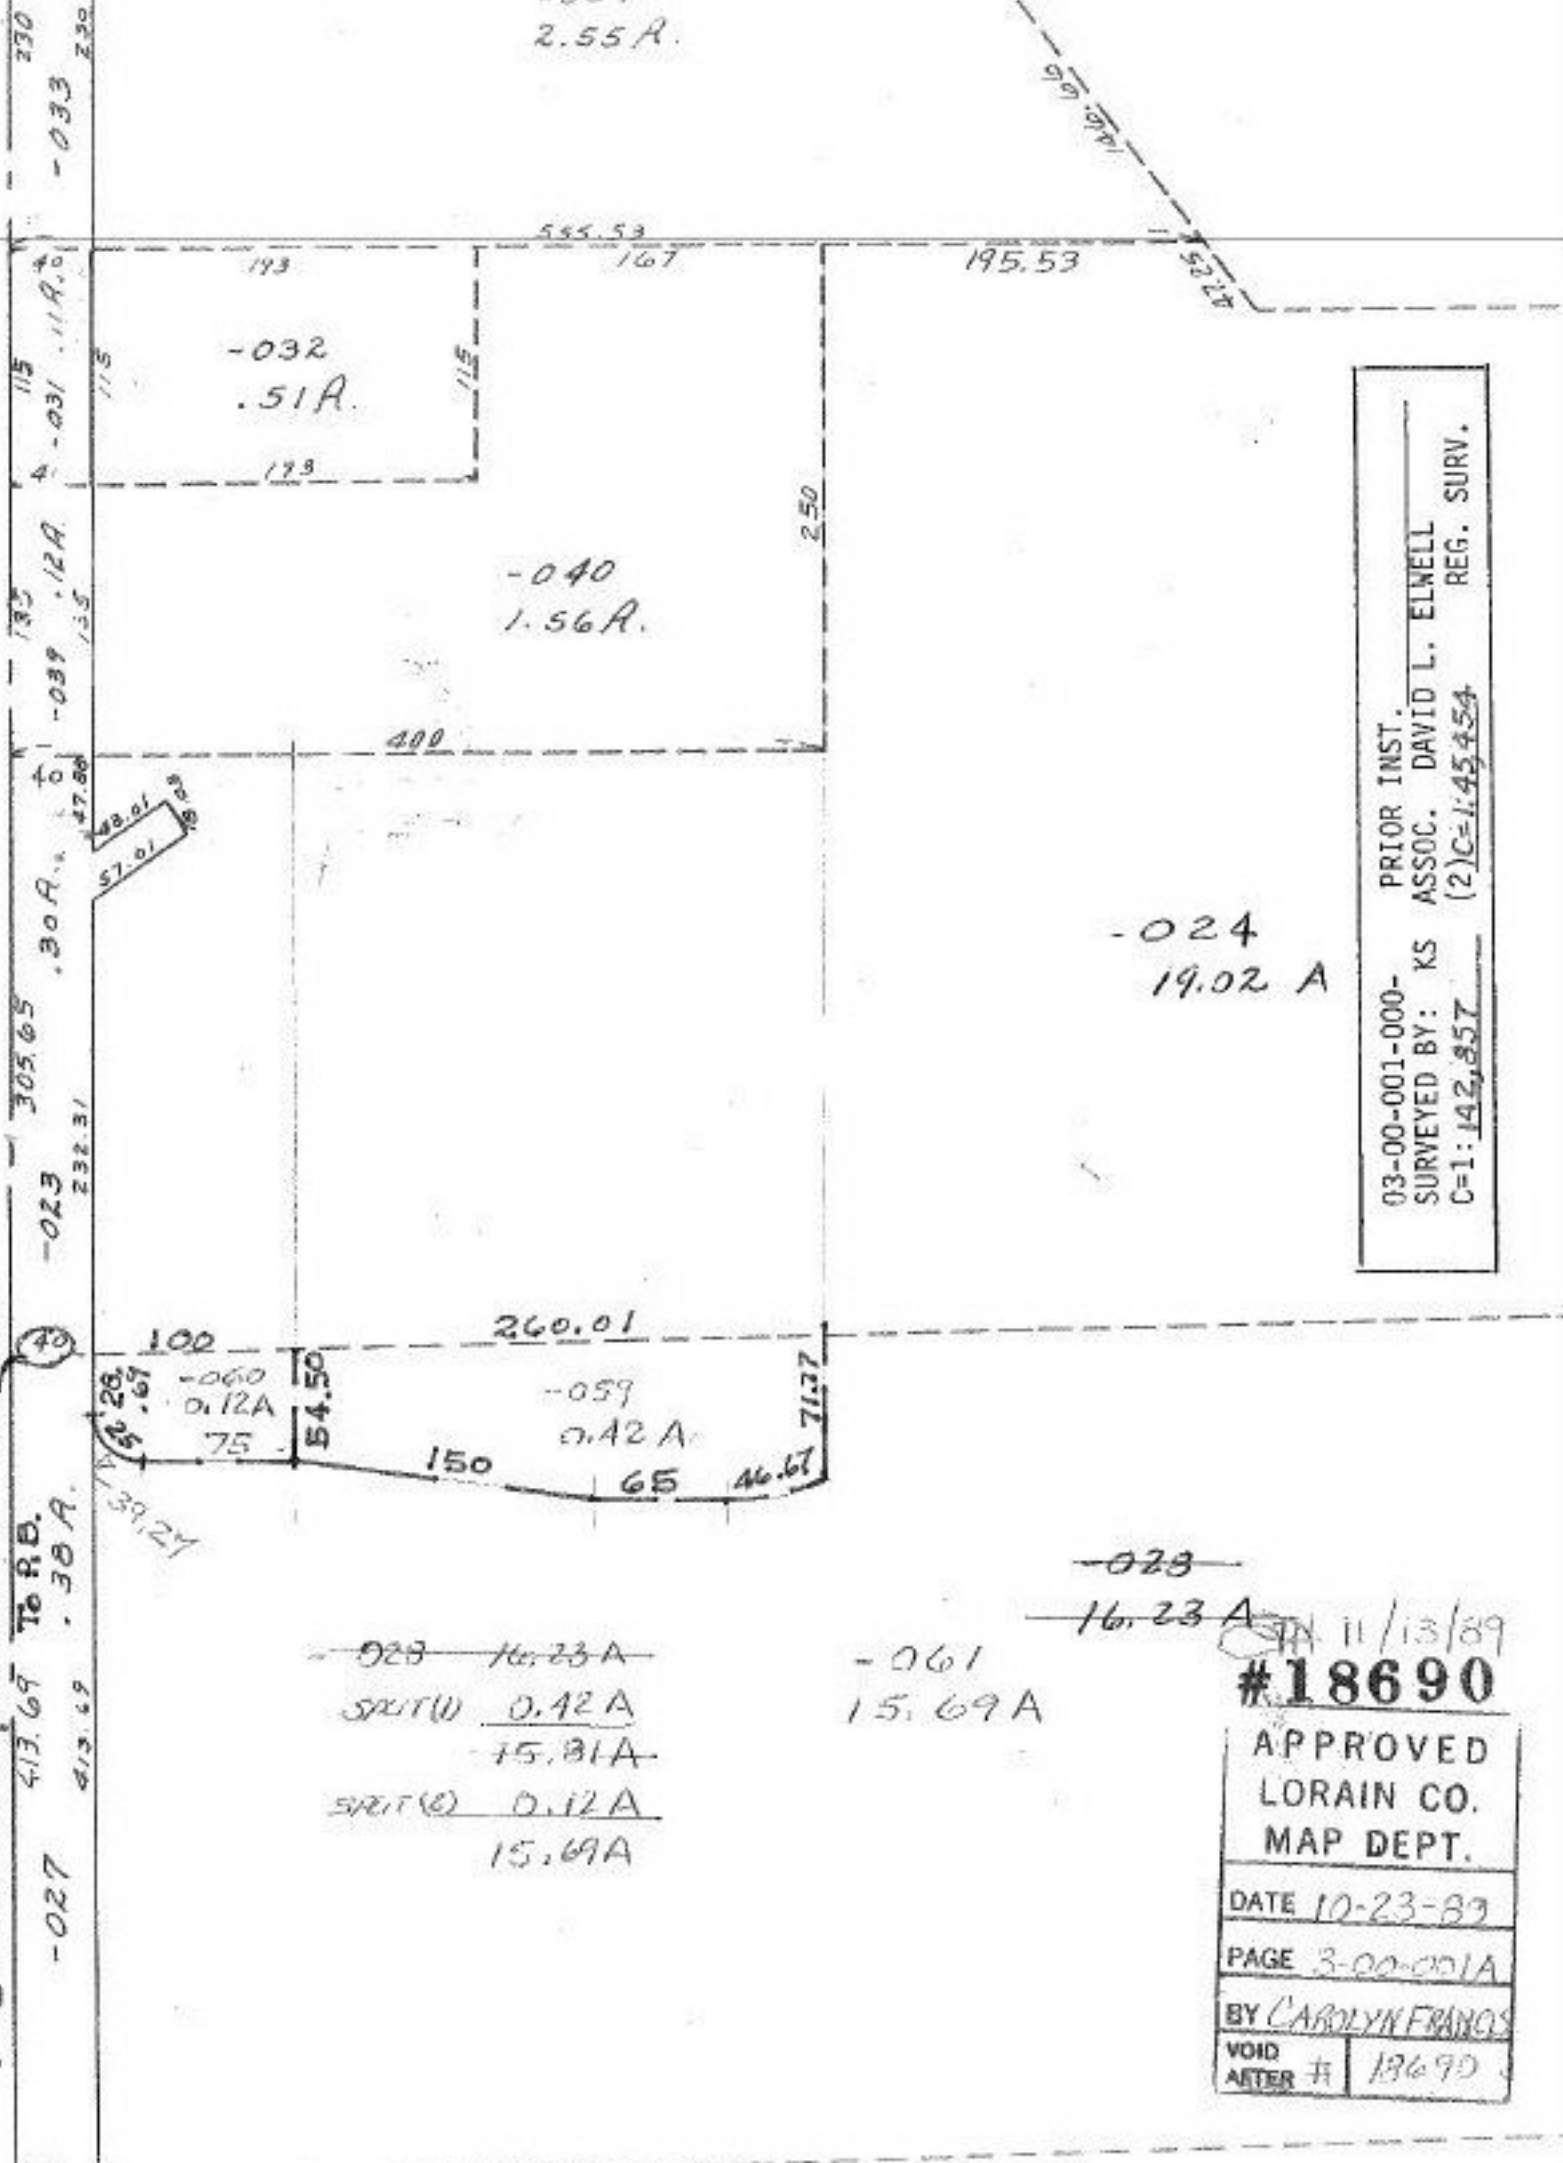

03-00-001-000-
 SURVEYED BY: KS ASSOC. DAVID L. ELLWELL
 C-1: 142,857 (2) C-1: 45,454
 REG. SURV.
 PRIOR INST.

APPROVED
 LORAIN CO.
 MAP DEPT.
 DATE 10-23-89
 PAGE 3-00-001A
 BY CAROLYN FRANCIS
 VOID AFTER # 18690

~~028~~ 16.23 A
 SPLIT (U) 0.42 A
 15.81 A
 SPLIT (C) 0.12 A
 15.69 A

-061
 15.69 A

~~028~~
 16.23 A

11/13/89
 #18690