


RD.

~~011 1.18 A~~ 173.30
 84.89
~~010 1.76 A~~ 88.41
 Comb. 2.74 A
 SL 627.63
 442.80
 -009 1070.43
 50.86 A.

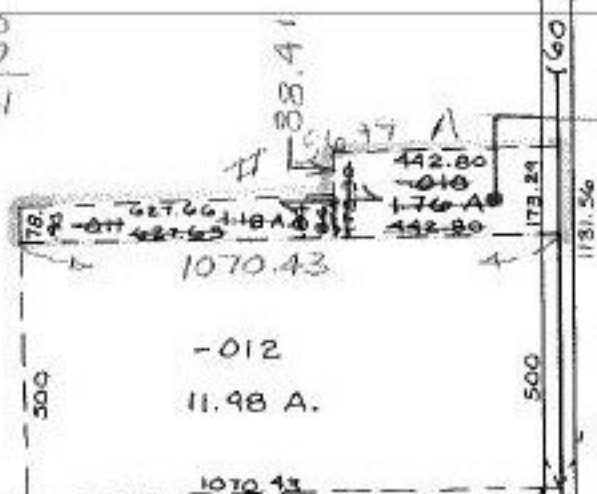

-013
2.94 A

04
00 A.

3


RD. 1125

-005
28.00 A.

2680

-006
25.00 A.

-008
36.48 A.

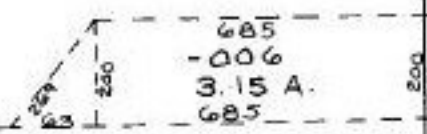

-002
42.00 A.

12

WHITEHEAD RD

COMBINATION

15-00-003-000-010
-011

12/20/89
#18699A

APPROVED LORAIN CO. MAP DEPT.	
DATE 11-13-89	
PAGE 15-A	
BY CAROLYN FRANCIS	
VOID METER #	18699A