

DEED CHECK-DESCRIPTIONS IS COVERING

03-00-109-125-008 & 06-22-013-101-011


SEE 3-00-109-B NEED ACREAGES BREAKDOWN AS TO HOW MUCH ACREAGES IS IN ELYRIA LOT 13 &

255.3 SHELFIELD LOT 109

3000

175.92

169.0

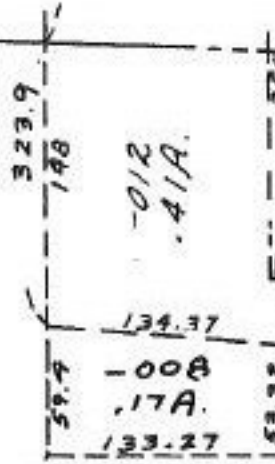

186.387 Sq feet.
= To 4.278 = To 4.28A.

-003 0.17 A.
-008 1.10
-011 3.40
4.50

-011 3.40A.

BLVD # 115190
18700A

APPROVED
LORAIN CO.
MAP DEPT.

DATE 12-19-89

PAGE 6-9

BY CAROLYN FRANCIS

WORD AFTER # 18700A

2.44 A. Pl.
1068

13

101

178°50'

396.57
N.0°54' W

30.5'
N0°59' E

S84°06'39" W

286.87
-010 322.99 .13A.
306.60

N 82° 27' 06" E

20.9479
57°32'
558'
33

800 -001
5.57 A.

395.8
247.25

" DEED CHECK ONLY "

-006 1.74A.