


SEE 2-02-006-B

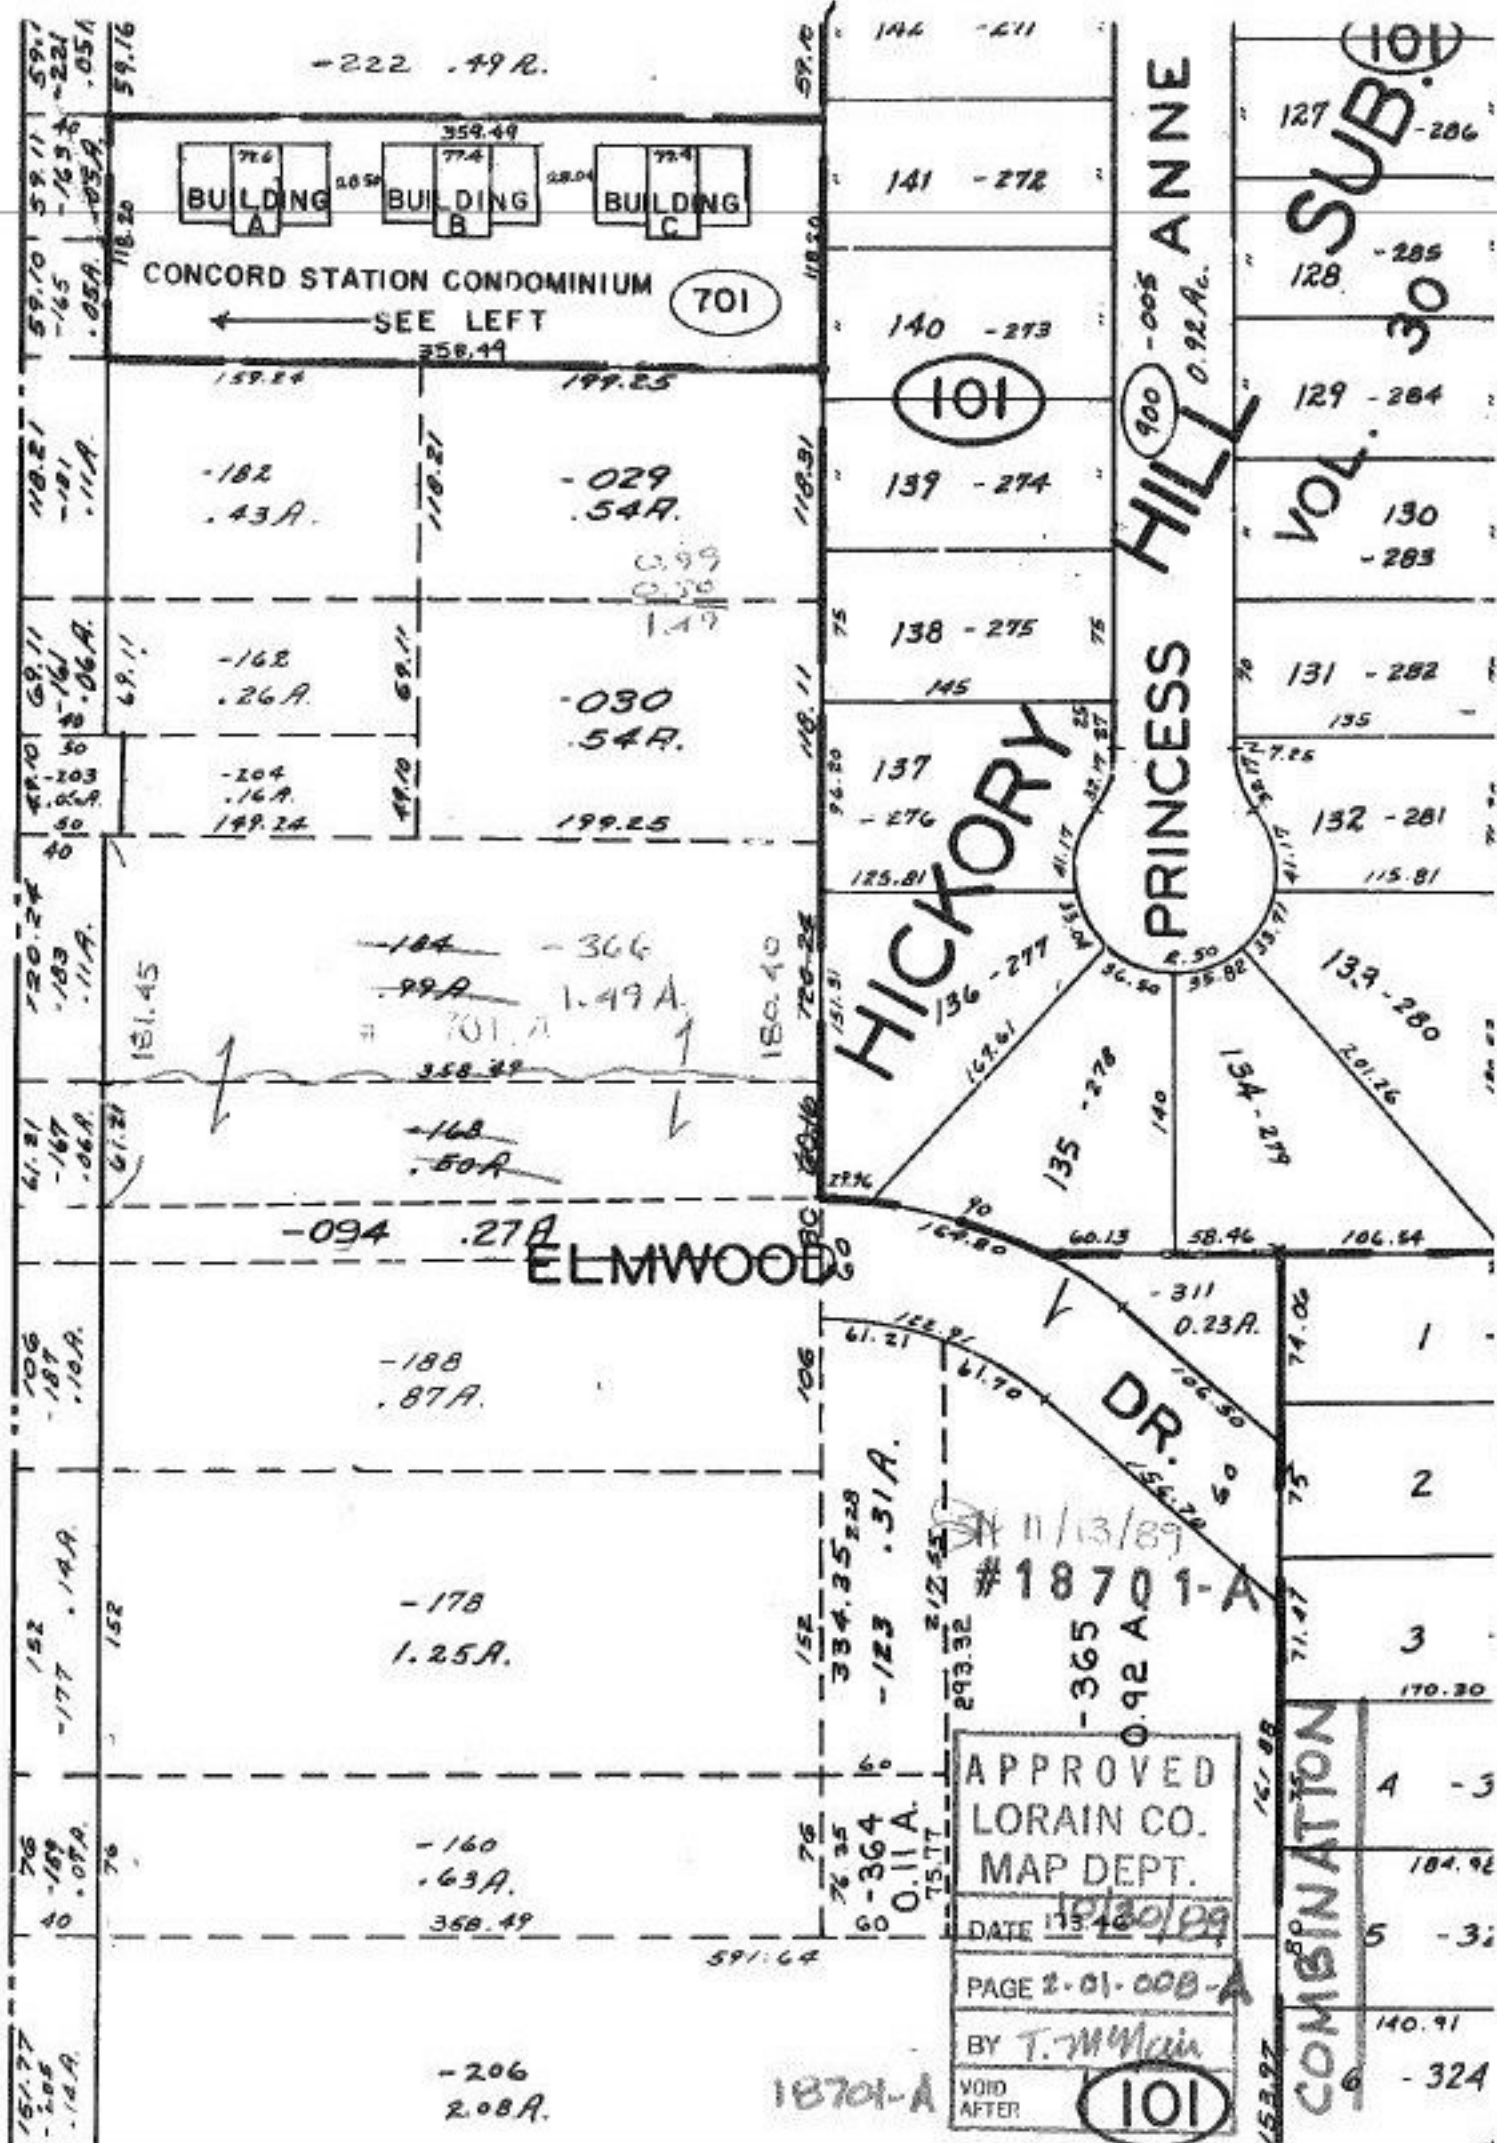

APPROVED
LORAIN CO.
MAP DEPT.
DATE 11/13/89
PAGE 2-01-008-A
BY T. M. McLean
VOID AFTER

101

18701-A