


Deed Check RD.

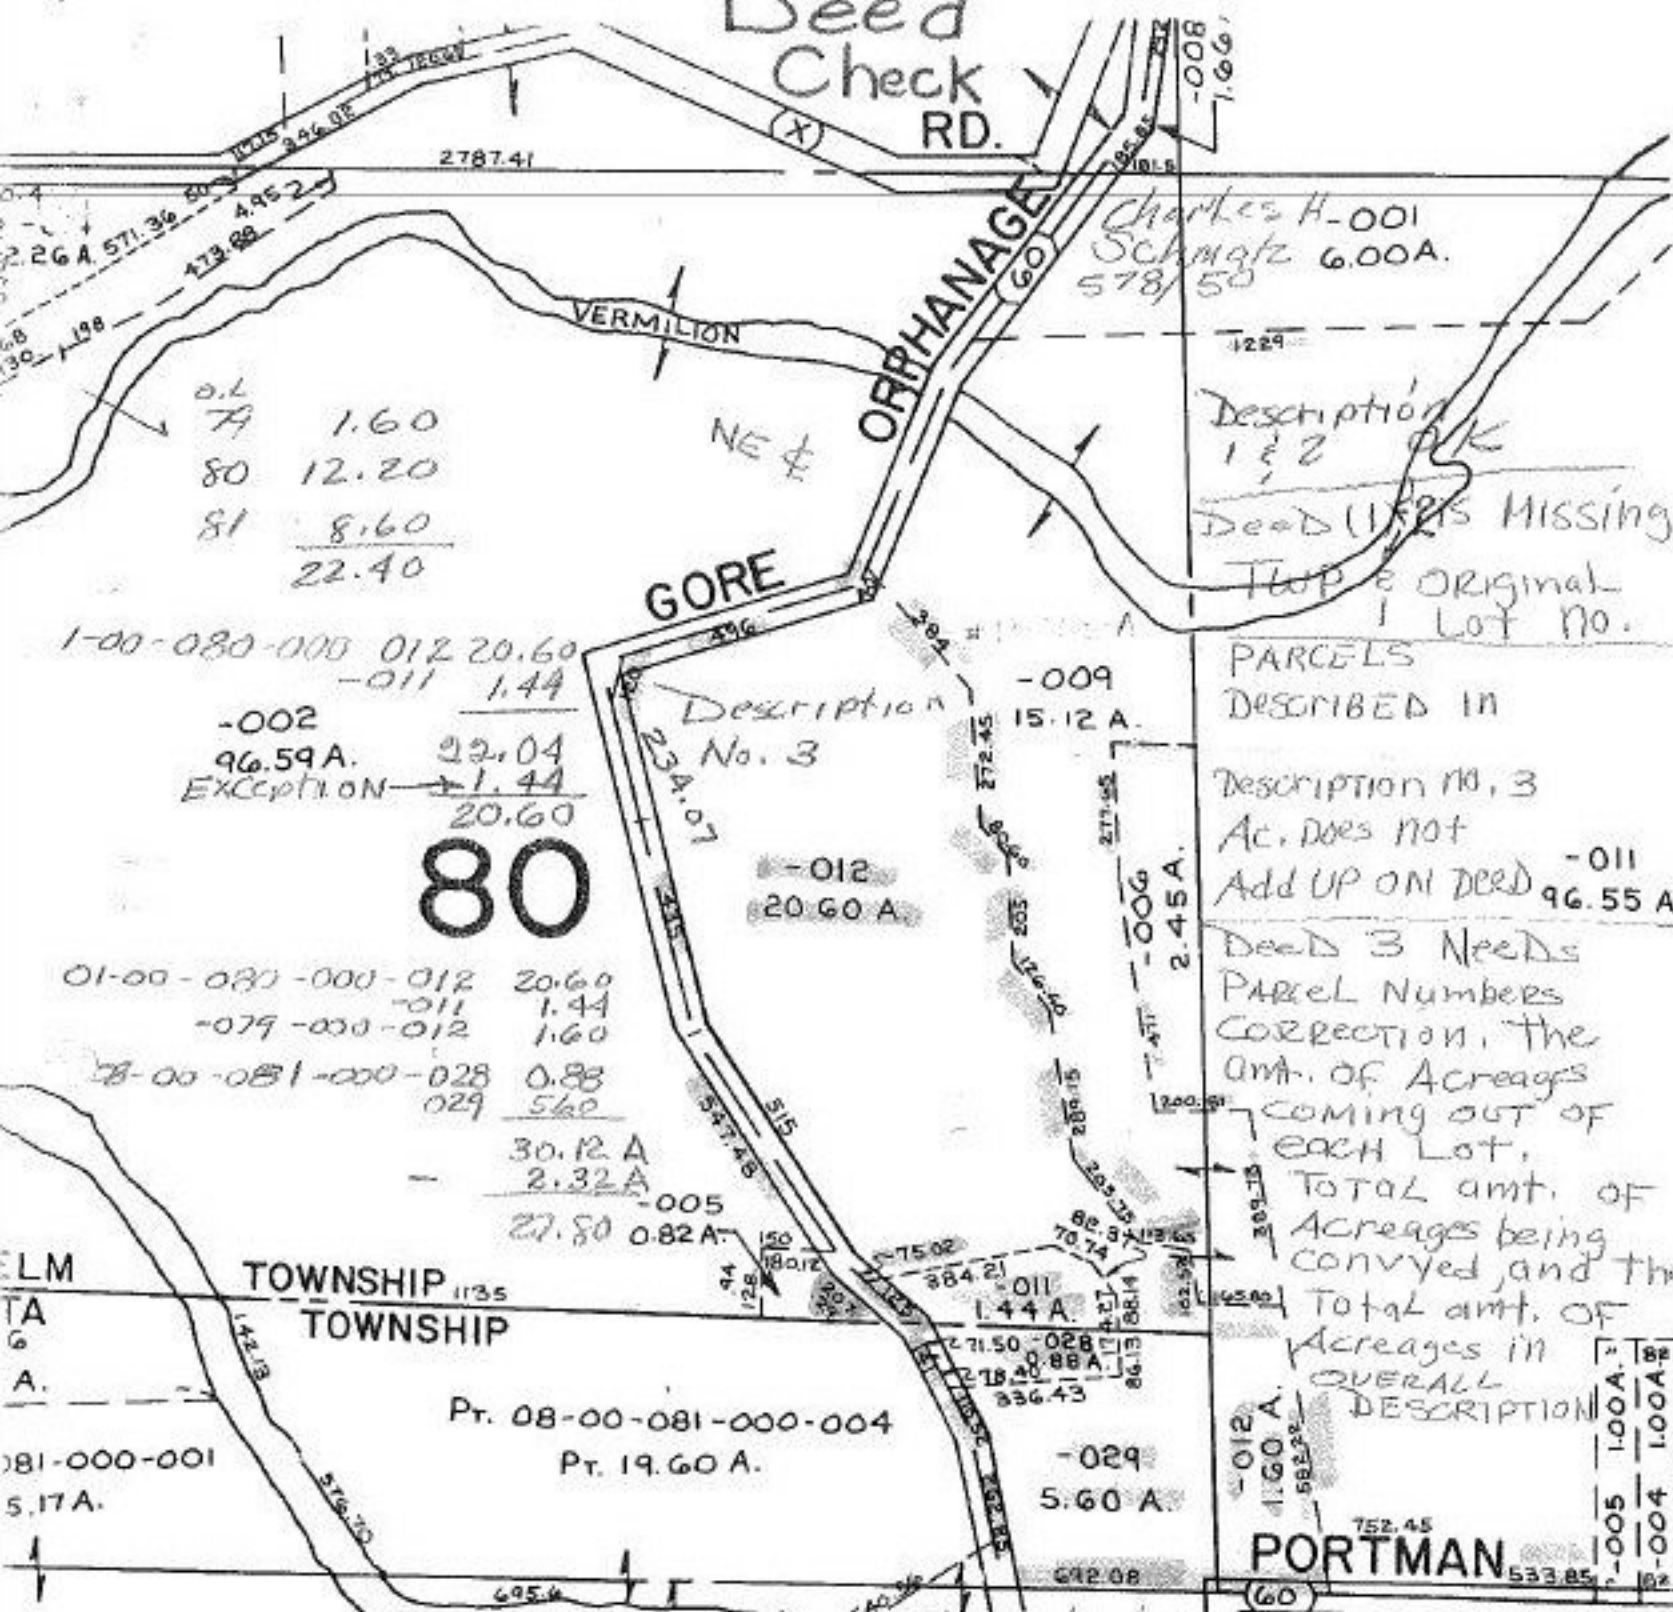

o.l
79 1.60
80 12.20
81 8.60
22.40

1-00-080-000 012 20.60
-011 1.44
-002 22.04
96.59A. 22.04
EXCEPTION - 1.44
20.60

80

01-00-080-000-012 20.60
-011 1.44
-079-000-012 1.60
08-00-081-000-028 0.88
029 5.60

30.12 A
2.32 A
27.80 0.82 A

Pr. 08-00-081-000-004
Pr. 19.60 A.

Charles H. 001
Schnitz 6.00A.
578/50

Description
1 & 2
Deed 1182's Missing
True Original
1 Lot No.

PARCELS DESCRIBED IN
Description No. 3
Ac. does not
Add UP ON Deed 96.55 A

Deed 3 Needs
Parcel Numbers
CORRECTION. The
amt. of Acreages
COMING OUT OF
EACH LOT.
TOTAL amt. of
Acreages being
conveyed, and the
Total amt. of
Acreages in
OVERALL
DESCRIPTION

PORTMAN

08-00-080-000-028 +.88
-029 +5.60
EXCEPTION 6.48
0.88
5.60

EXCEPTION -
01-00-080-000 011 1.44
08-00-081-000-028 0.88
TOTAL EXCEPTIONS 2.32

SEE 8-A
PARCELS' Acreages being
DESCRIBED
01-00-080-000-012 20.60
08-00-081-000-029 5.60
01-00-079-000-012 1.60
TOTAL Acreages 27.80
WITH EXCEPTIONS 2.32
30.12

#18703-A

APPROVED
LORAIN CO.
MAP DEPT.
DATE 10-30-89
PAGE 1-I
CAROLYN
FRANCIS
VOID
#18703A