


139 79.63x167.57
 160 0.05A = 15x140. - 160 1500x
 -139 79.68x
 94.68

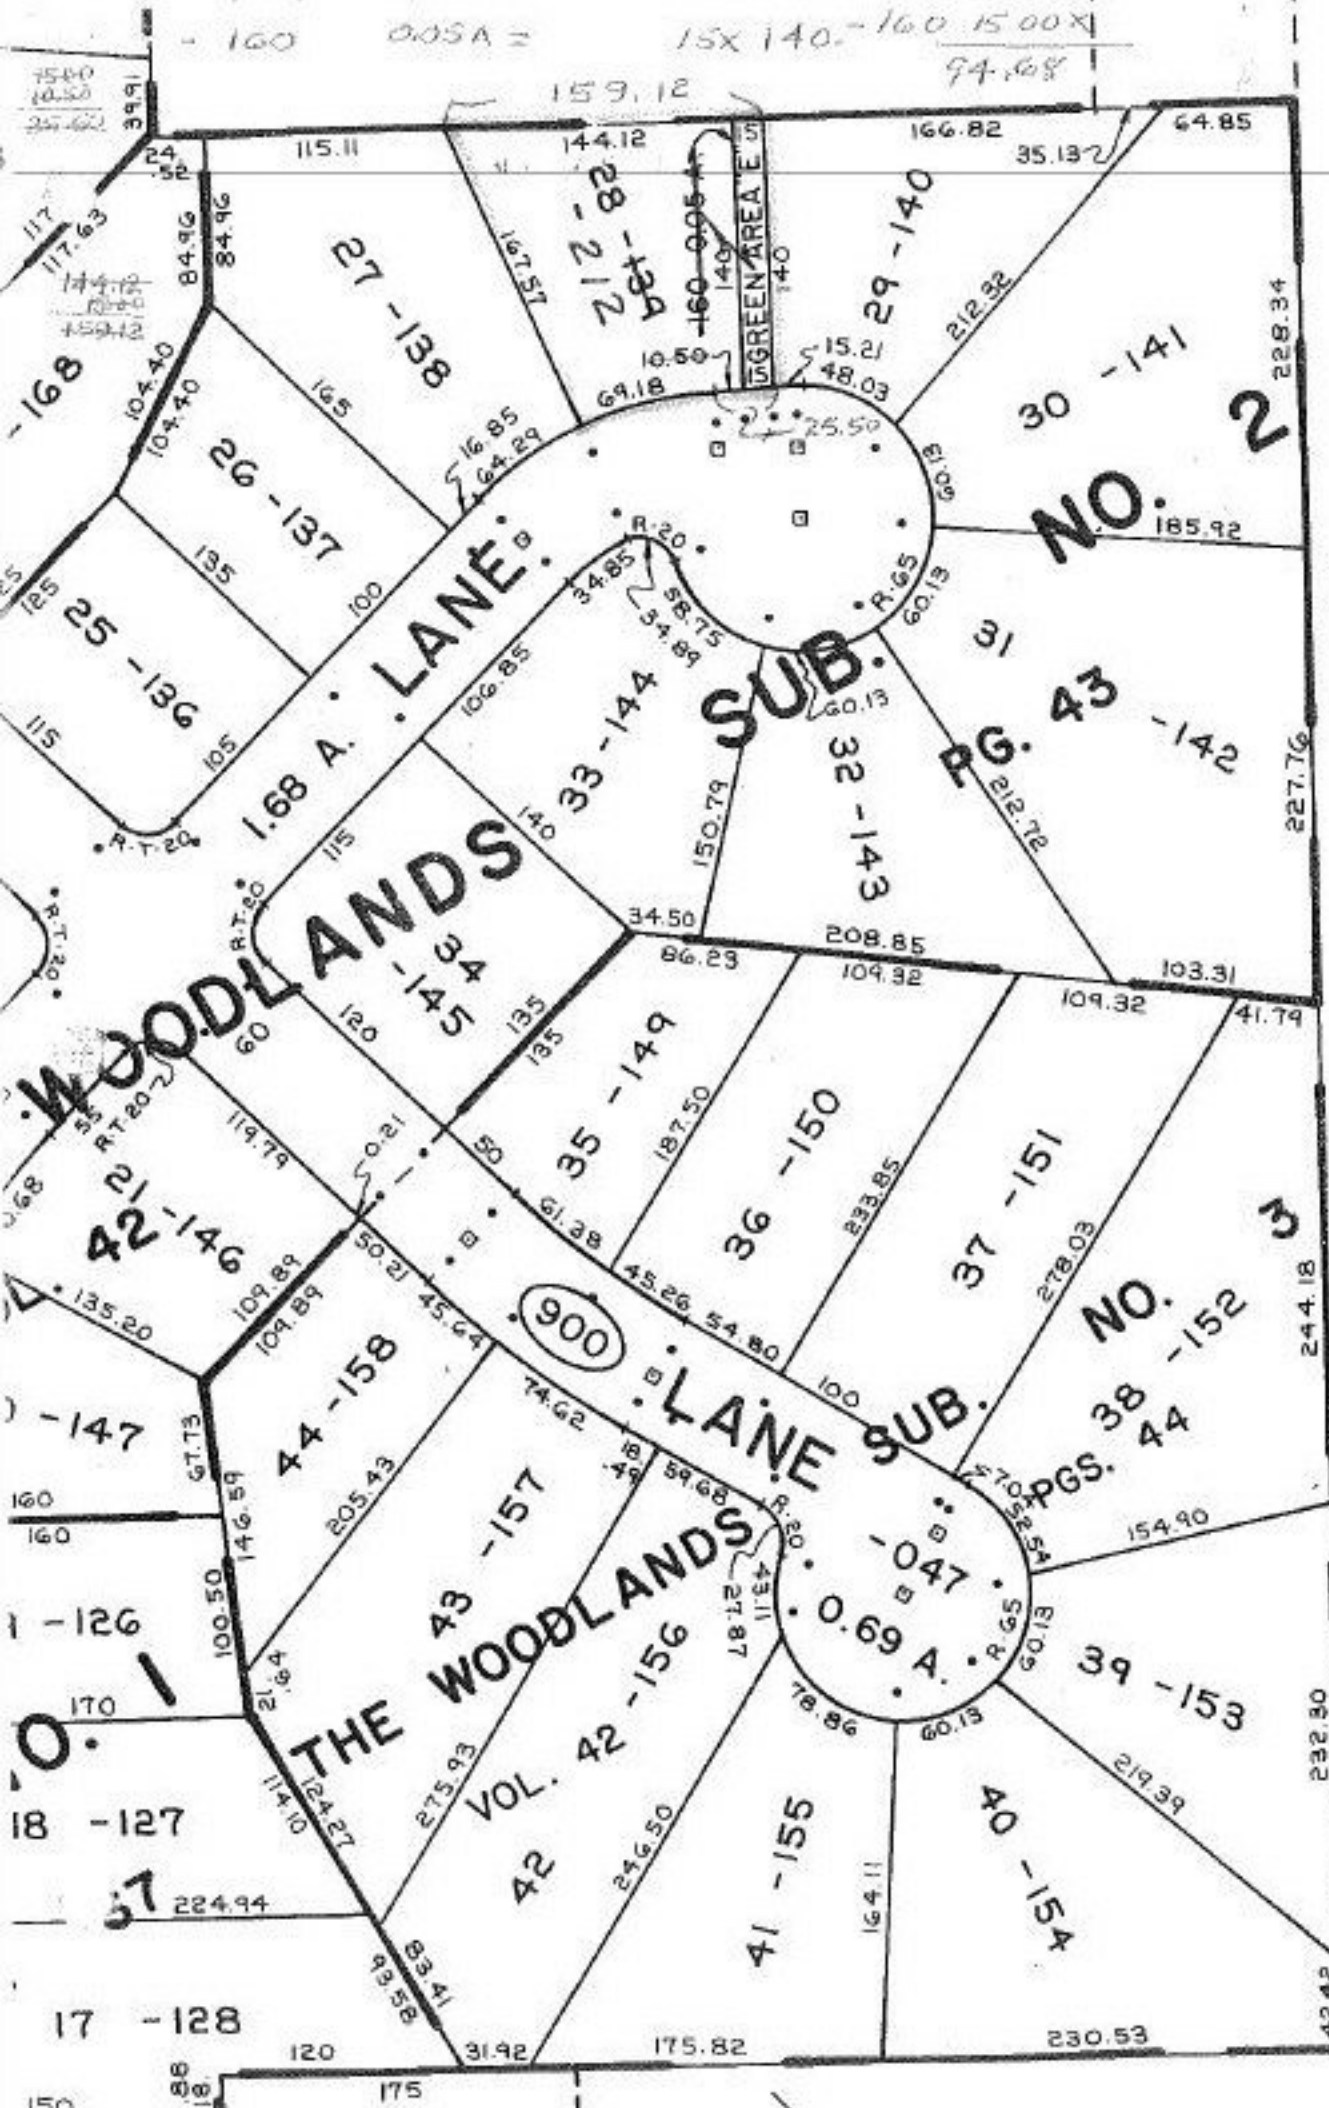

COMBINATION

SEE 4-

04-00-019-144-139
 160

12/15/89
 #18705A

APPROVED LORAIN CO. MAP DEPT.	
DATE 11-13-89	
PAGE 4-00-019K	
CAROLYN BY FRANCIS	
VOID AFTER	# 18705A