


301.32
191.32
110.00

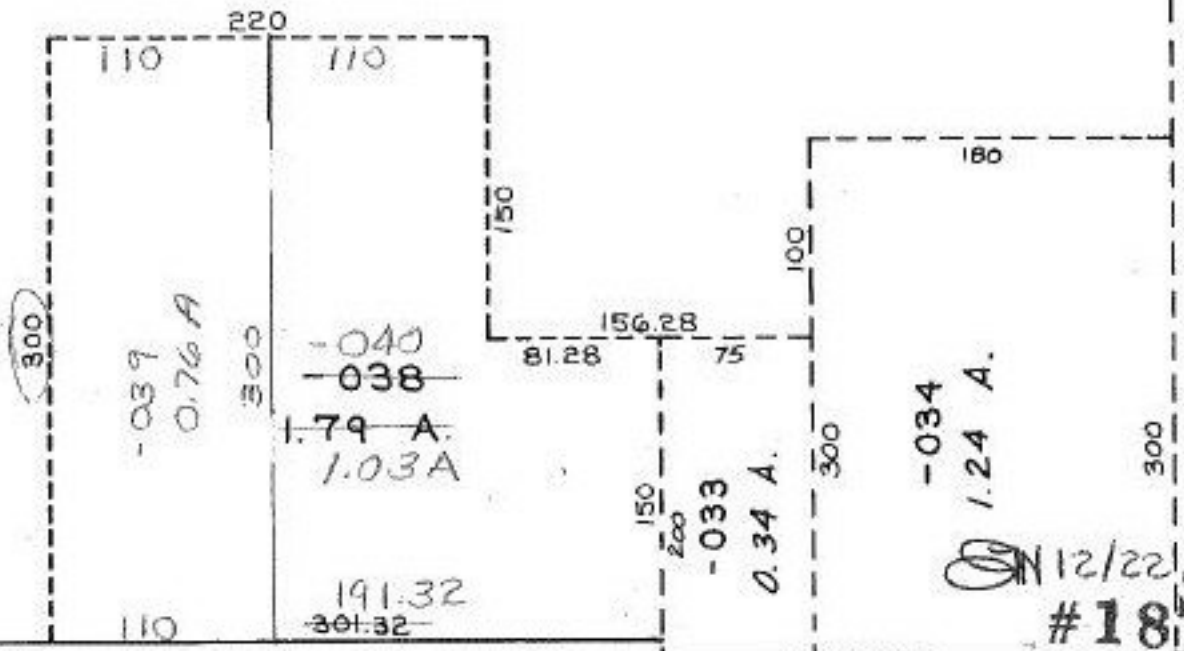

12/22/89
#18711

50 -037

0.52 A.

180 #18711

451.27
WALKER RD

585 Ft. P. OF Beginning

1.79 A
0.76 A
1.03 A

SEE 4-D

04-00-030-142- PRIOR INST.
 SURVEYED BY: DEED SURVRYED BY HENRY REITZ ENG,
 C-1: INF.

APPROVED
 LORAIN CO.
 MAP DEPT.
 DATE 11-06-89
 PAGE 400-030-4
 BY CAROLYN FRANCIS
 VOID # 18711