


-011 31.71  
 5.17  
 26.54

2629.94  
 750.00  
 1879.94

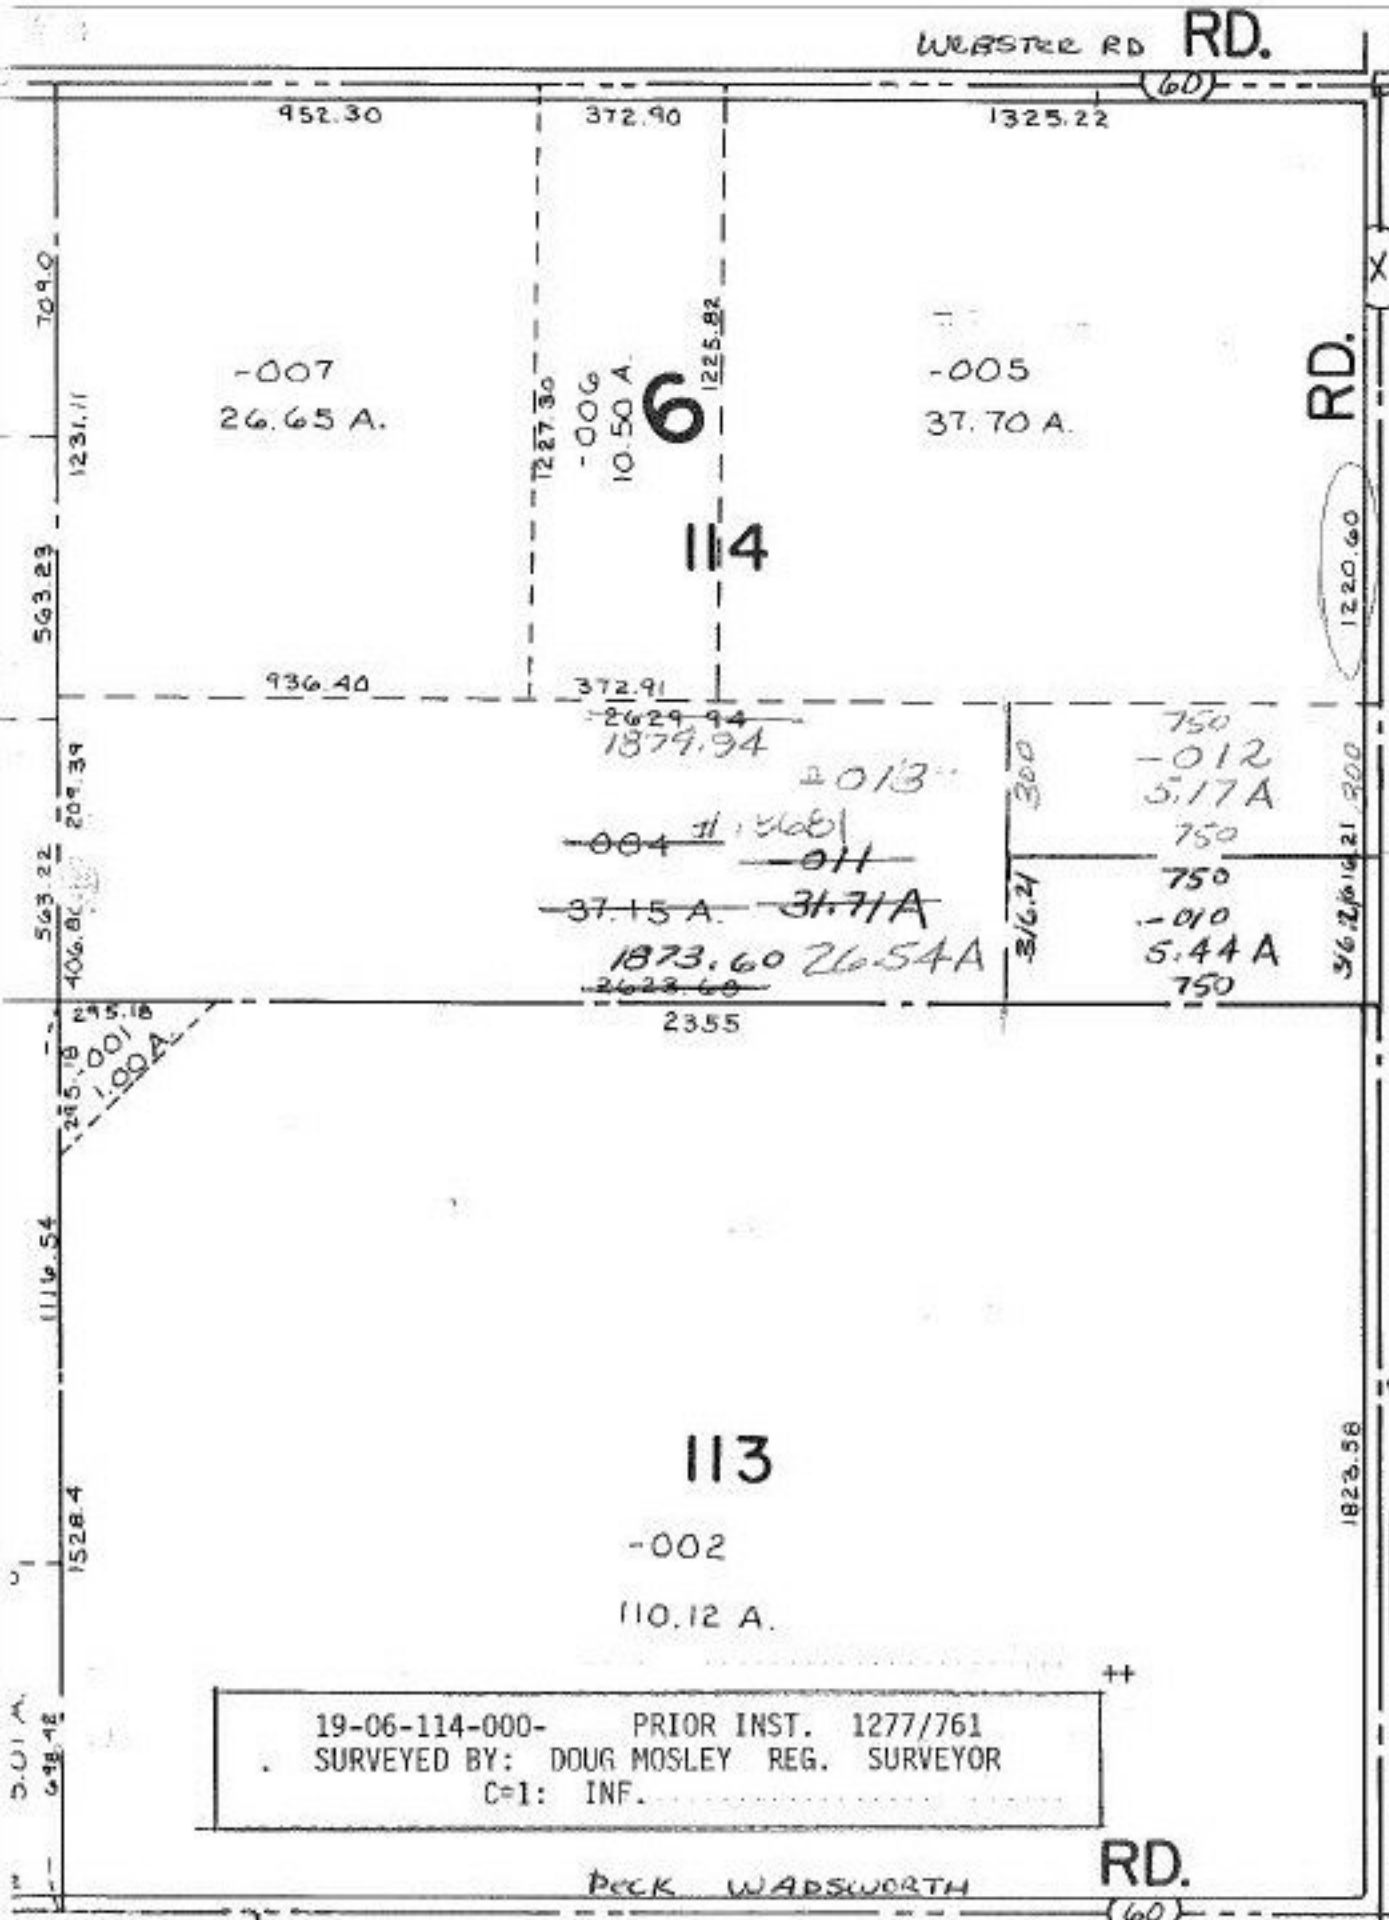

main Box

WEBSTER RD

RD.

WHITEHEAD RD

PECK WADSWORTH RD.

19-06-114-000- PRIOR INST. 1277/761  
 SURVEYED BY: DOUG MOSLEY REG. SURVEYOR  
 C=1: INF.

11/3/90  
**#18714**  
 APPROVED  
 LORAIN CO.  
 MAP DEPT.  
 DATE 7-39  
 PAGE 19-A  
 BY CAROLYN FRANCIS  
 VOID AFTER # 18714