

SEE 3-H

-006 12.41
11.20
1.21

-015
10.00 A.


N.L.
~~081 11.20 A~~
~~088 1.19 A~~
comb 12.39 A

W.L. 364.01
3506
399.07
E.L. 446.34
42.99
489.33

N. COMBINATION - 072

Y. 04-00-005-000-034 43.96 A.

ST. L 145865
8
C
-006 2.37 A
-031 007 A.

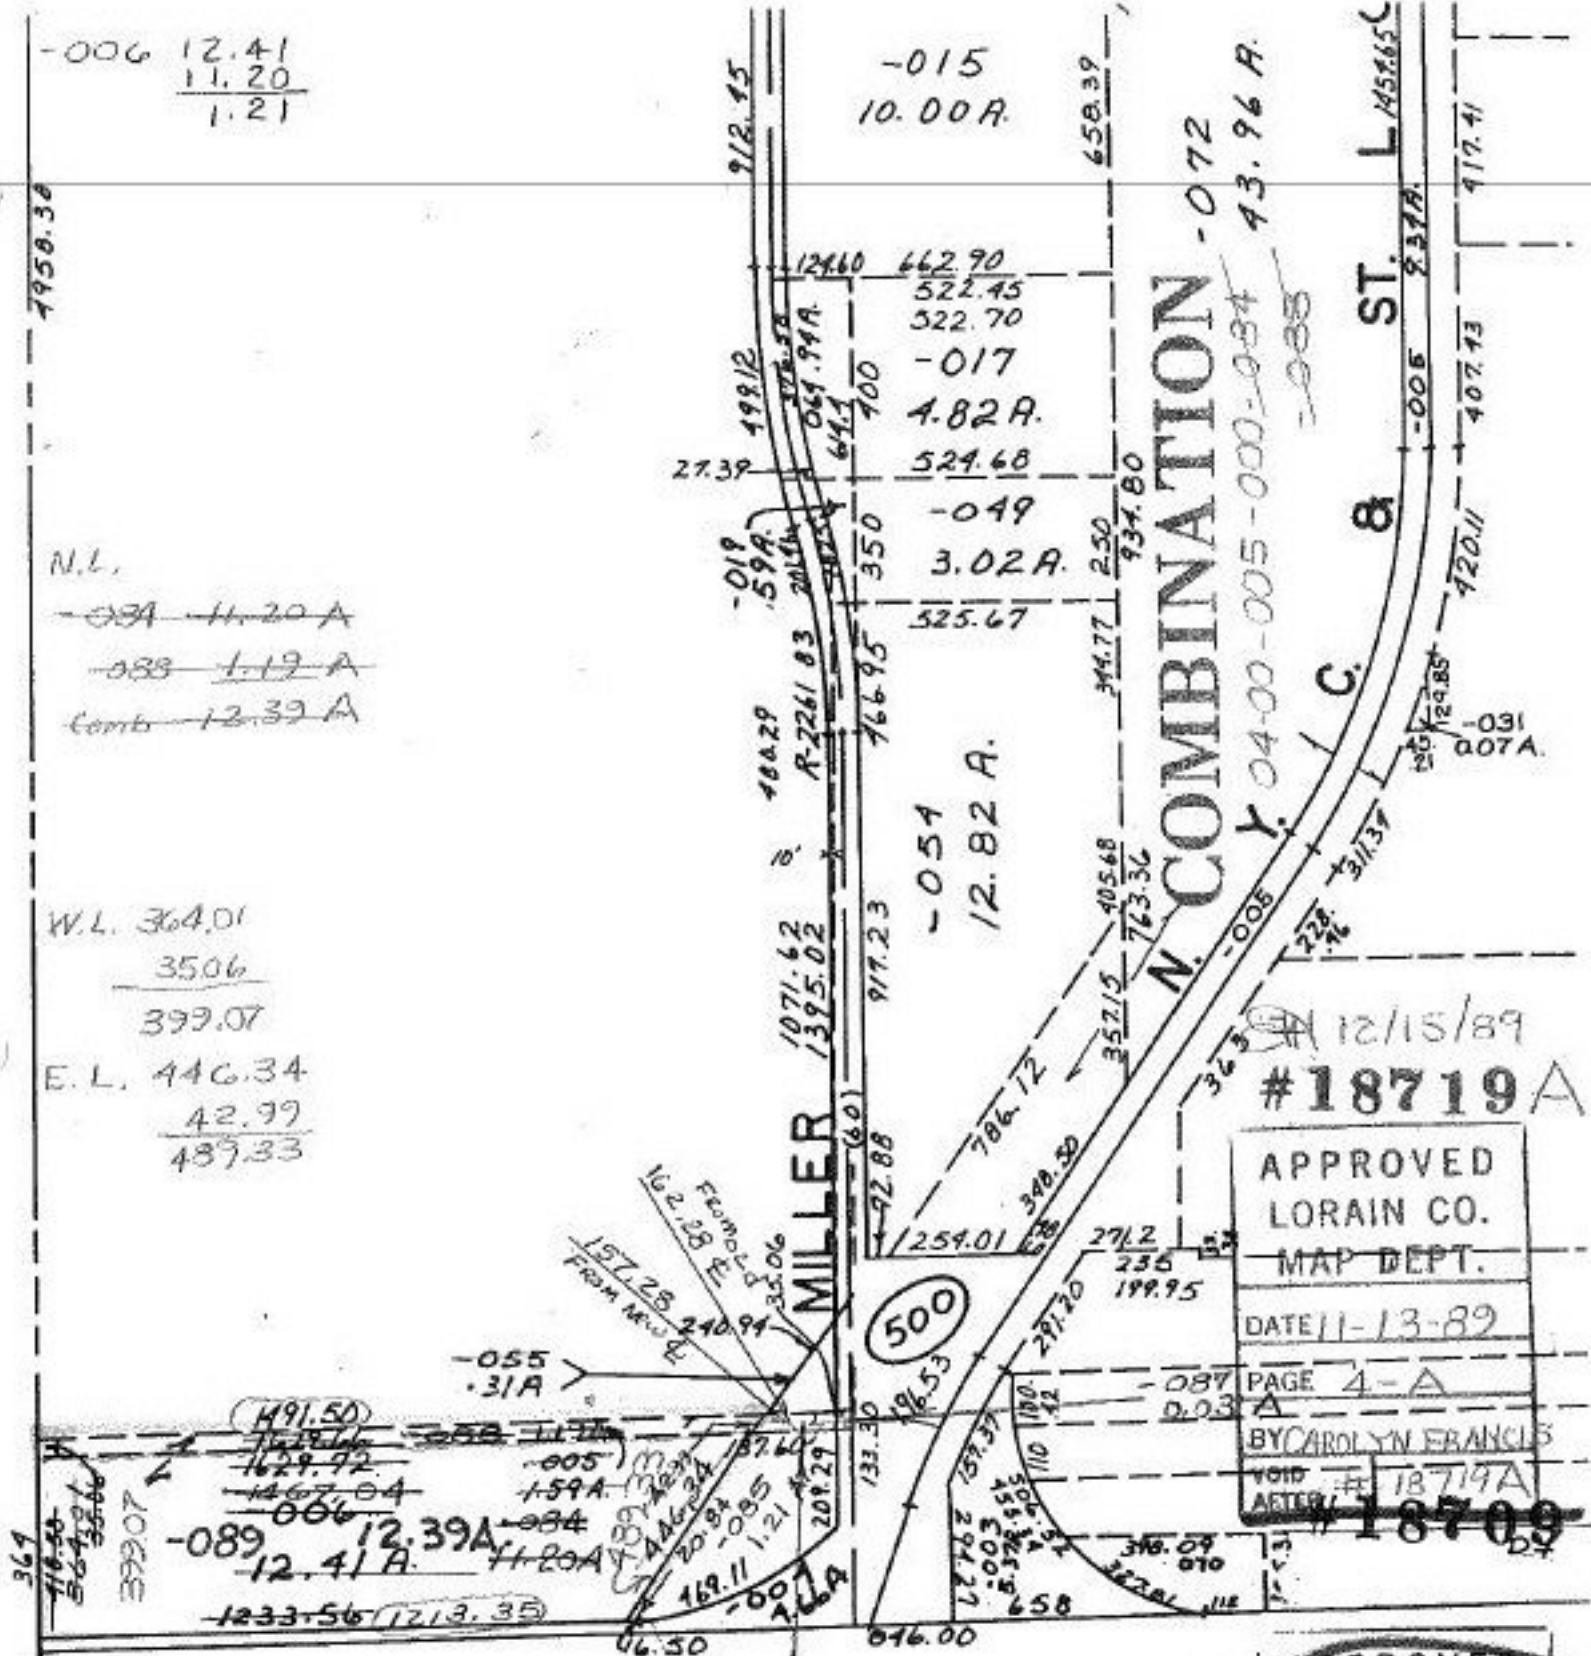

12/15/89
#18719A

APPROVED
LORAIN CO.
MAP DEPT.

DATE 11-13-89

PAGE 4-A

BY CAROLYN FRANCIS

VOID AFTER #18719A

18709

SEE APPROVED
LORAIN CO.
MAP DEPT.
DATE 11-13-89
PAGE 4-4
BY CAROLYN FRANCIS
VOID AFTER #18709

1233.56 1629.72
1213.35 1467.04
20.21 162.68
SURVEY 20.84 162.28
15.00 & PER
SURVEY

04-00-005-000- PRIOR INST. 961/388 SURVEYED BY:
DOUGLAS P. McLAUGHLIN, REG. SURVEYOR. C=1: JNF