

58

MAPLE STREET DEDICATION

Pt. (900) -001 Pt.

RES
LADH
33
33

ST. 327.20

204.53	42	68.47	66	66	123
-073 0.76 A.	97.05 -072 0.09 A.	58.47 -071 0.15 A.	66 -070 0.15 A.	97 -069 0.15 A.	66 -068 0.15 A.
97.05	183	183	183	183	123


-009
1.06 A.

SEE SURVEY MAP BY
LAUNDON, SIMON, CAHL & ASSOC.
CC. 1:500,000

NO PRIOR INST. GIVEN AS THIS WAS A DEED ETC.

-010
8.10 A.

274.15

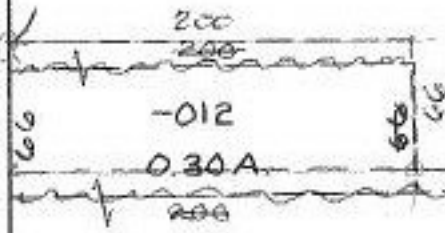

302.70

222.42

18-00-028-B

32.1

-013
5.10 A.

DEED & CHECK

(101) 12/29/89

18722-A

APPROVED
LORAIN CO.
MAP DEPT.

DATE 12-1-89

PAGE 18-00-028-A

BY T. McHain

WORD AFTER 18722 A