


FRONTAGE & DEPTH  
**HOMWOOD CORR.** PEP PLAT VOL 22, PG. 60  
 (DEPTH CORR. ON TRANSFER SHEET ONLY)

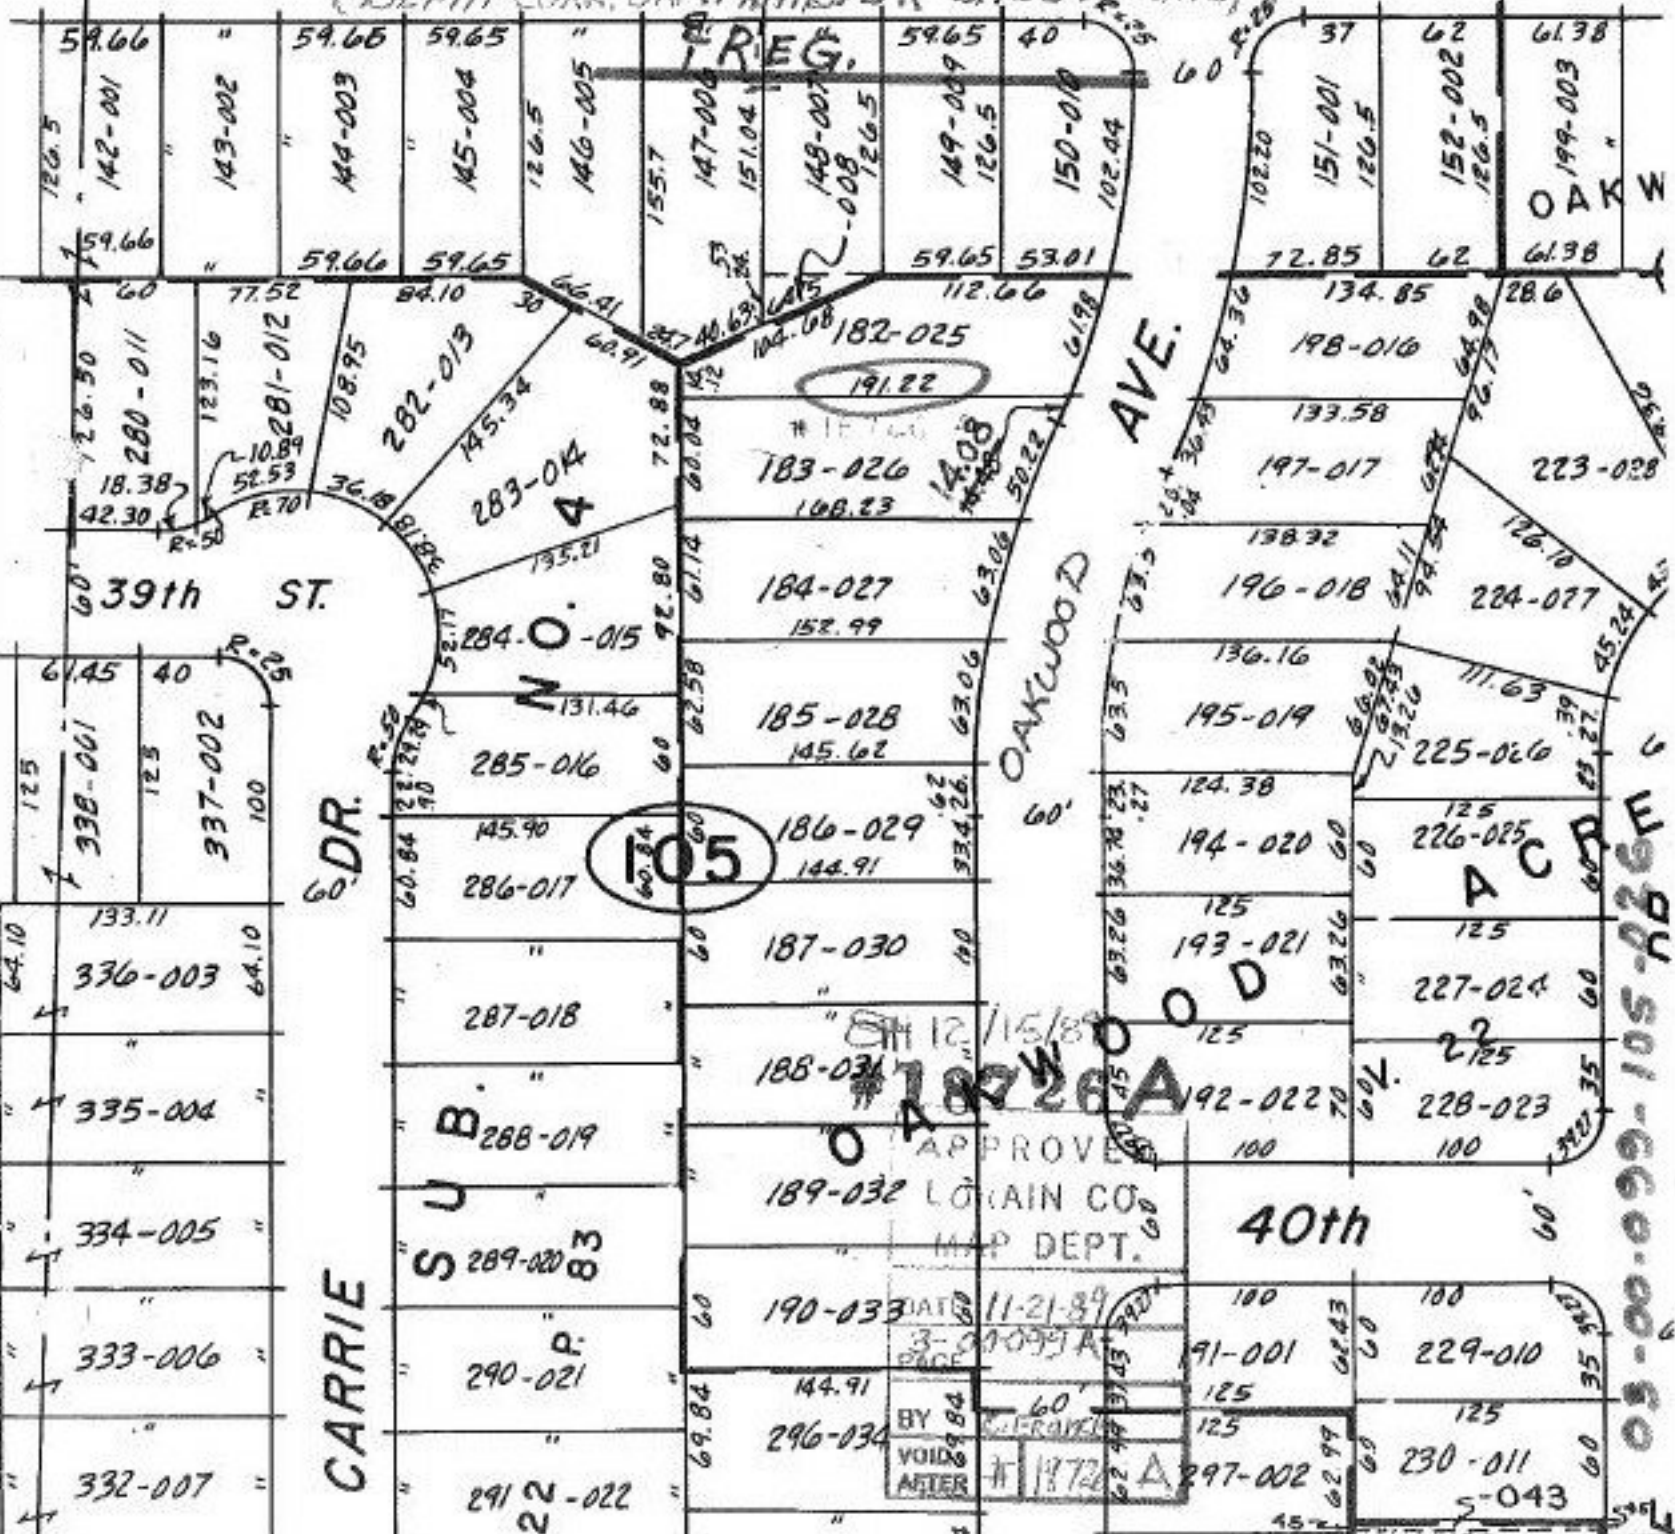

OAKWOOD

MAP CORR.

03-00-99-105-A26M