


MILAN

AVE.

PAR.

NAME CHANGE HISC. VOL. 7 P. 2083

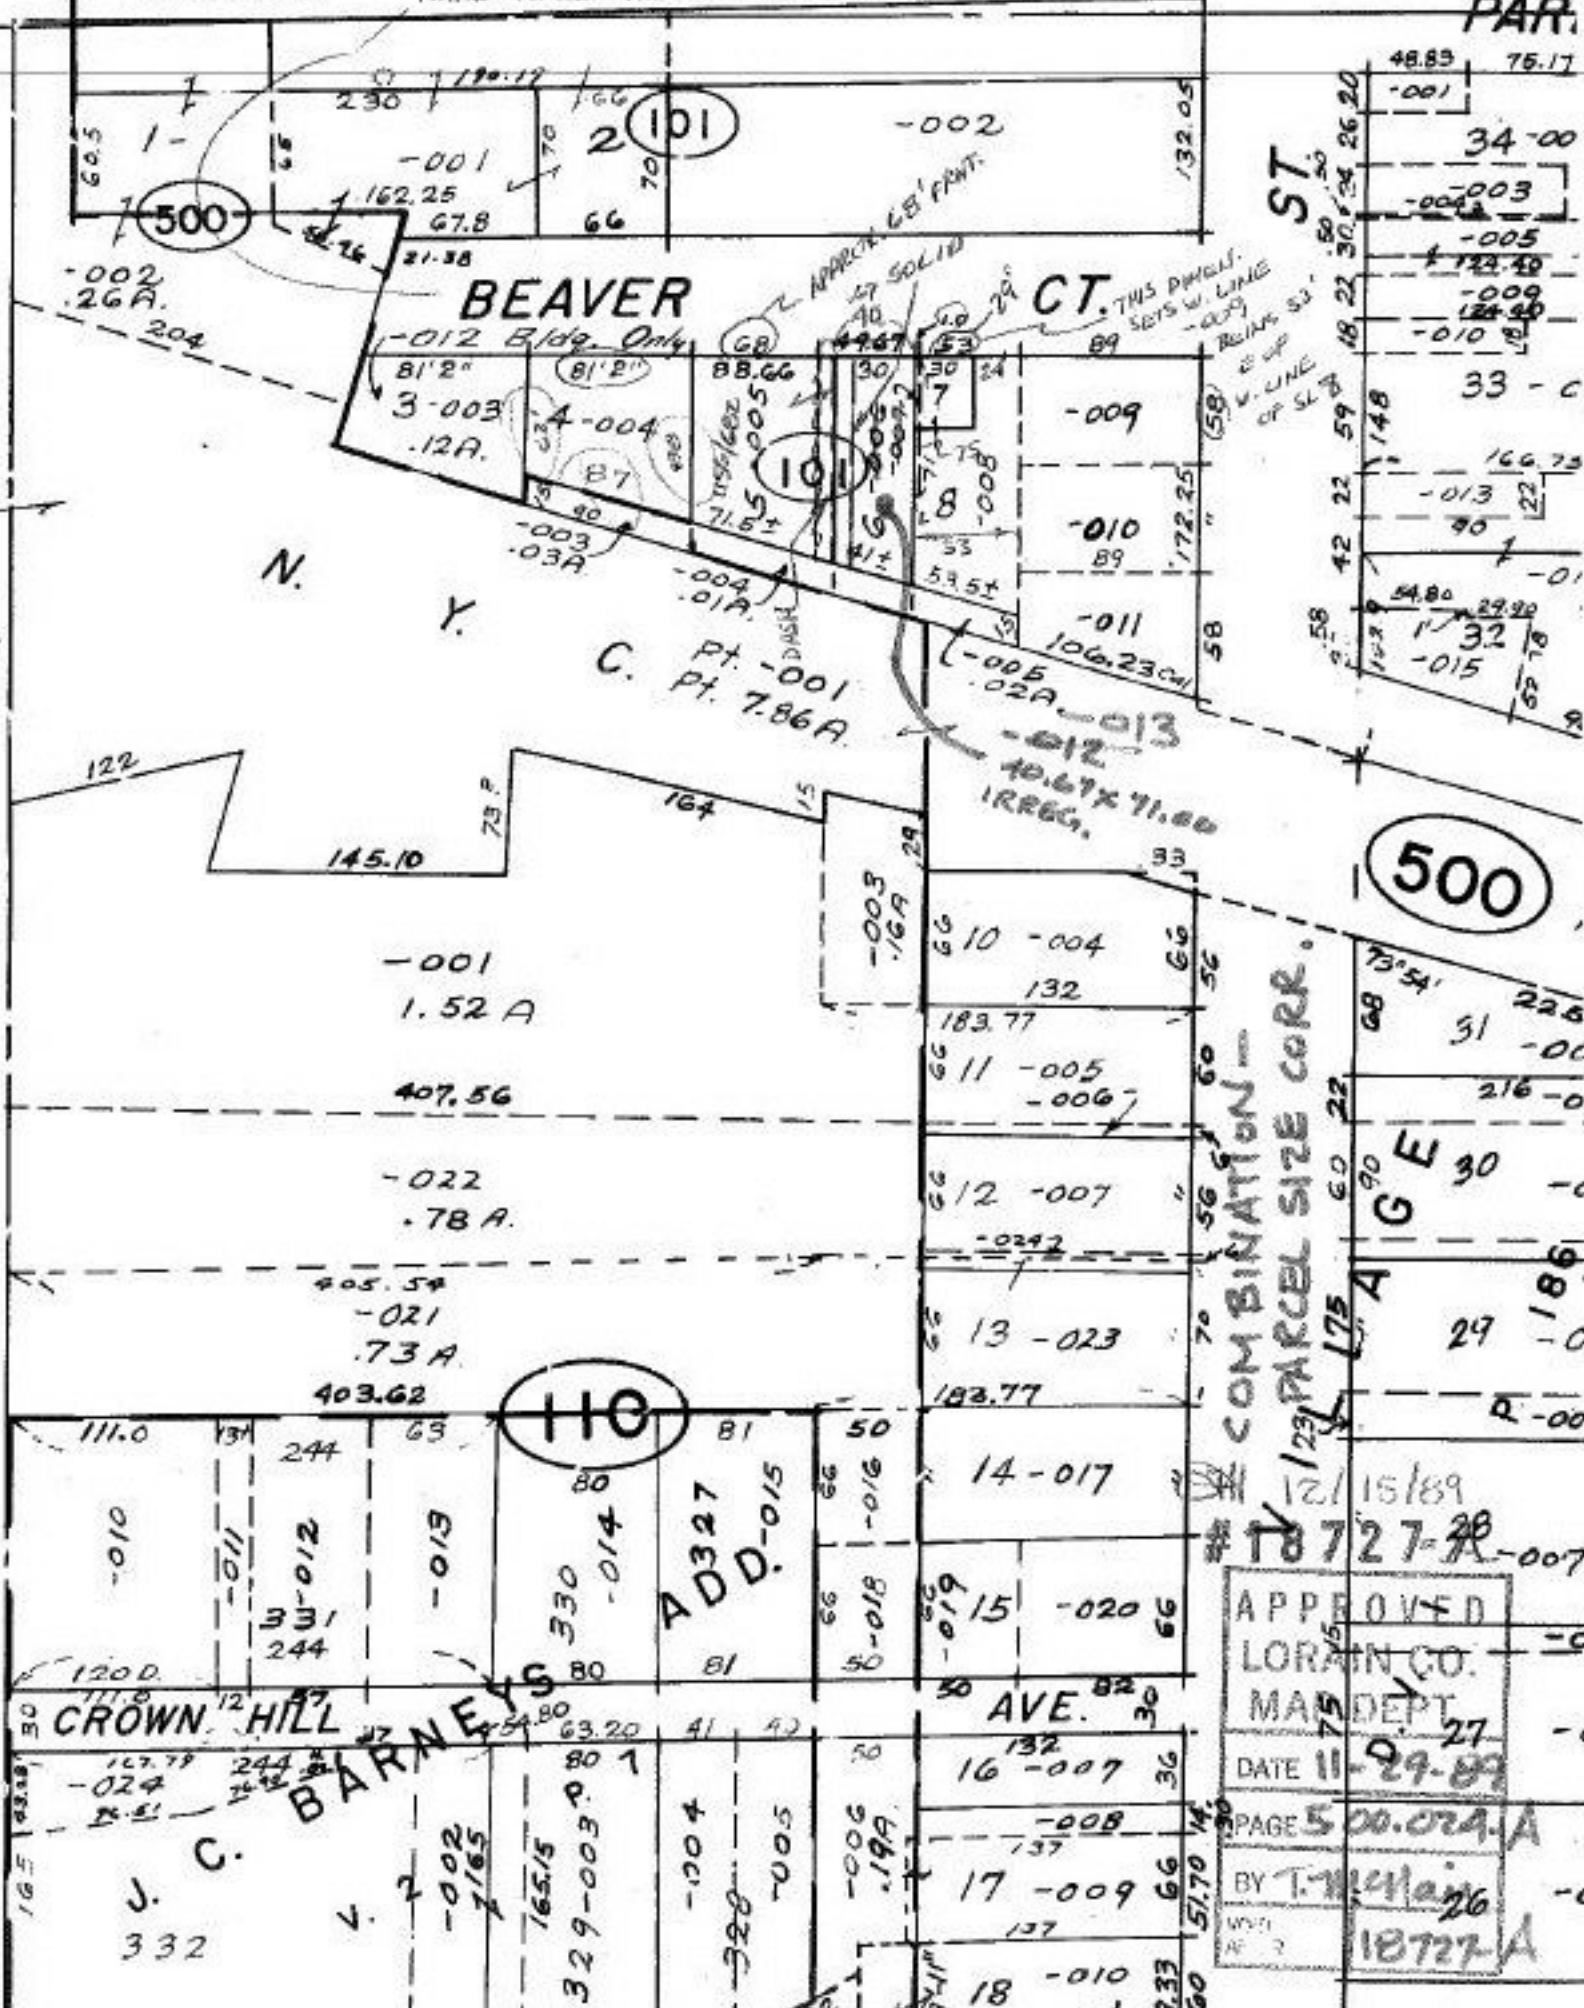

APPROVED
 LORAIN CO.
 MAN DEPT
 DATE 11-29-89
 PAGE 500.024.A
 BY T. McLean
 18727A

COMBINATION -
 1/23' PARCEL SIZE CORR.

110

500

J. C.

332

CROWN HILL

BARNEYS

AVE.

A D 327
 D D -015

12/15/89
 727-A-007

AGE 30

29 -0

2-00

186

186

48.85 75.17

34-00

33 - C

166.73

30

32

67.78

148

228

216-0

30

29 -0

2-00

186

186

34-00

33 - C

166.73

30

32

67.78

148

228

216-0

30

29 -0

2-00

186

186

