
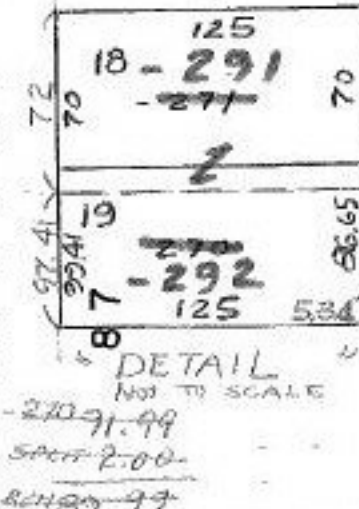


UNIVERSITY OAKS SUBDIVISION No. 2

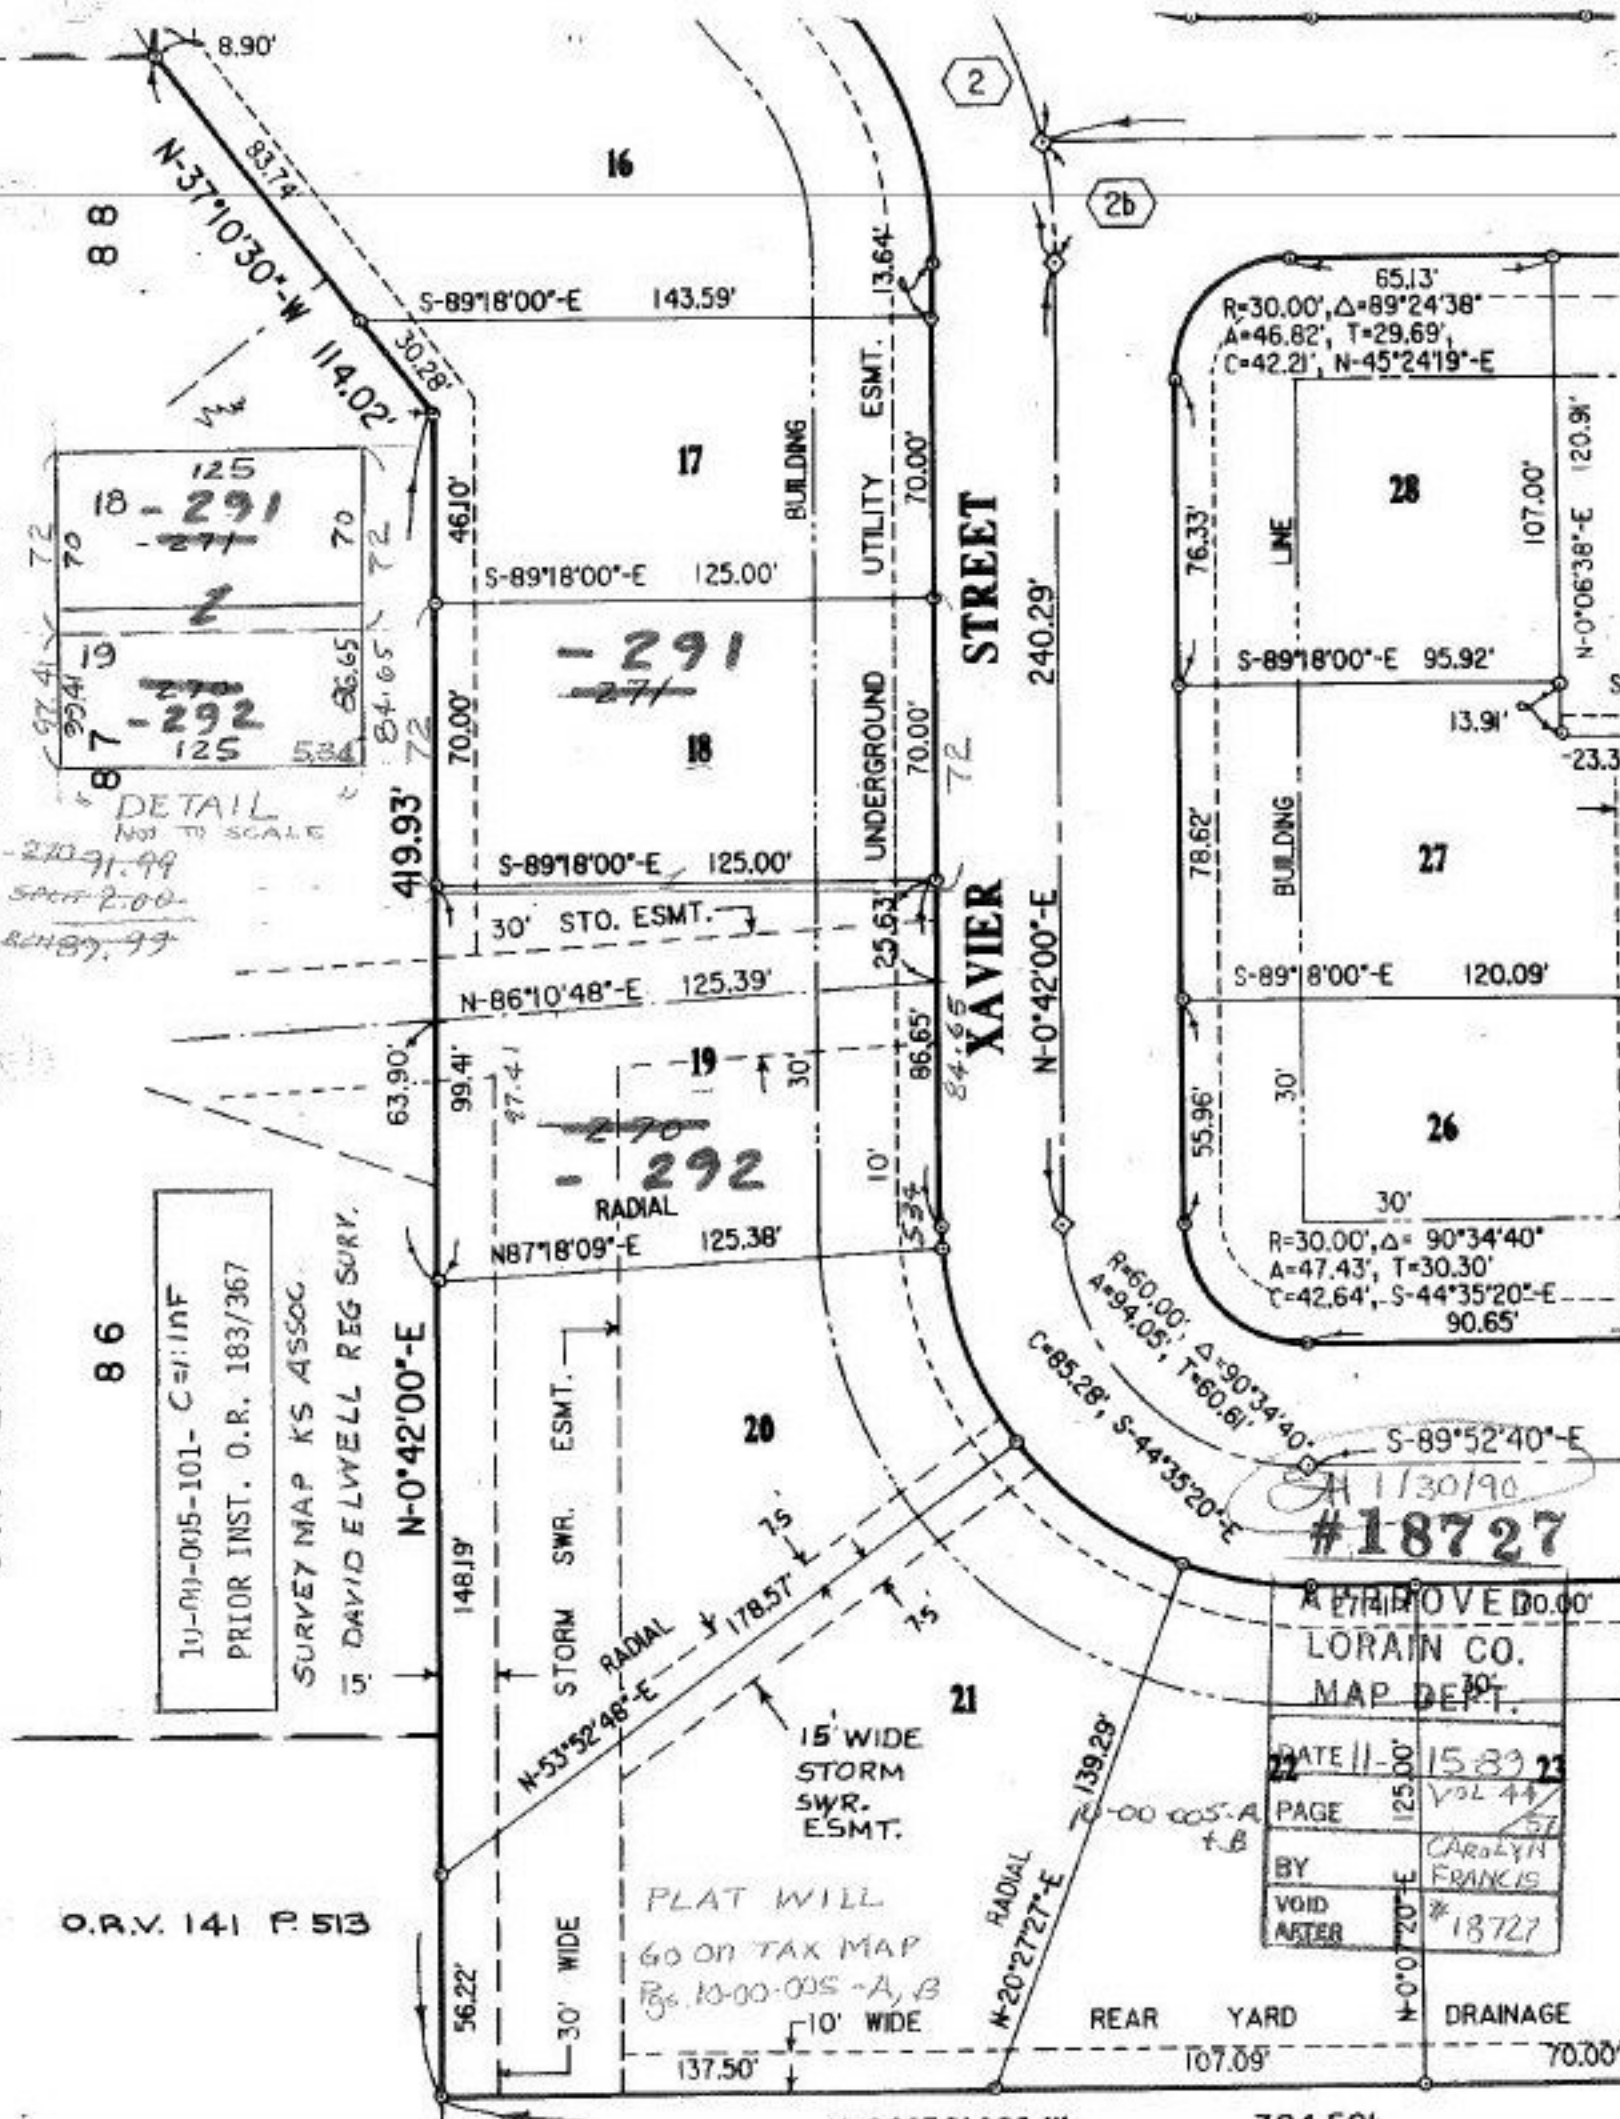

19-01-0015-101- C=1:1inF  
 PRIOR INST. O.R. 183/367  
 SURVEY MAP K S ASSOC  
 5 DAVID ELWELL REG SURV.

O.R.V. 141 P. 513

PLAT WILL GO ON TAX MAP Bc 10-00-005-A, B

APPROVE DO.00	
LORAIN CO. MAP DEPT.	
DATE 11-15-89	15-89-23
PAGE 125.00	VOL 44
BY CAROLYN FRANCIS	57
VOID AFTER #18727	

#1130/90  
 #18727

REAR YARD 107.09' DRAINAGE 70.00'

N-89°52'40"-W 384.59'