

324.52 N. LINE

339.20 N. LINE

-005
~~12.60 A.~~
12.84 A

-006
~~12.60 A.~~
12.84 A.

ACREAGE CORRECTION
PER SURVEY BY K.S.A.
CLOSURE I: III, III

VOID
8/28/90
SURVEY DOES NOT MATCH
TAX MAP.

9-13-90
[Signature]

#18729-A


APPROVED
LORAIN CO.
MAP DEPT.

DATE 12/5/89

PAGE 10-00-005-A

BY T. HOLLIS

VOID AFTER 18729-A

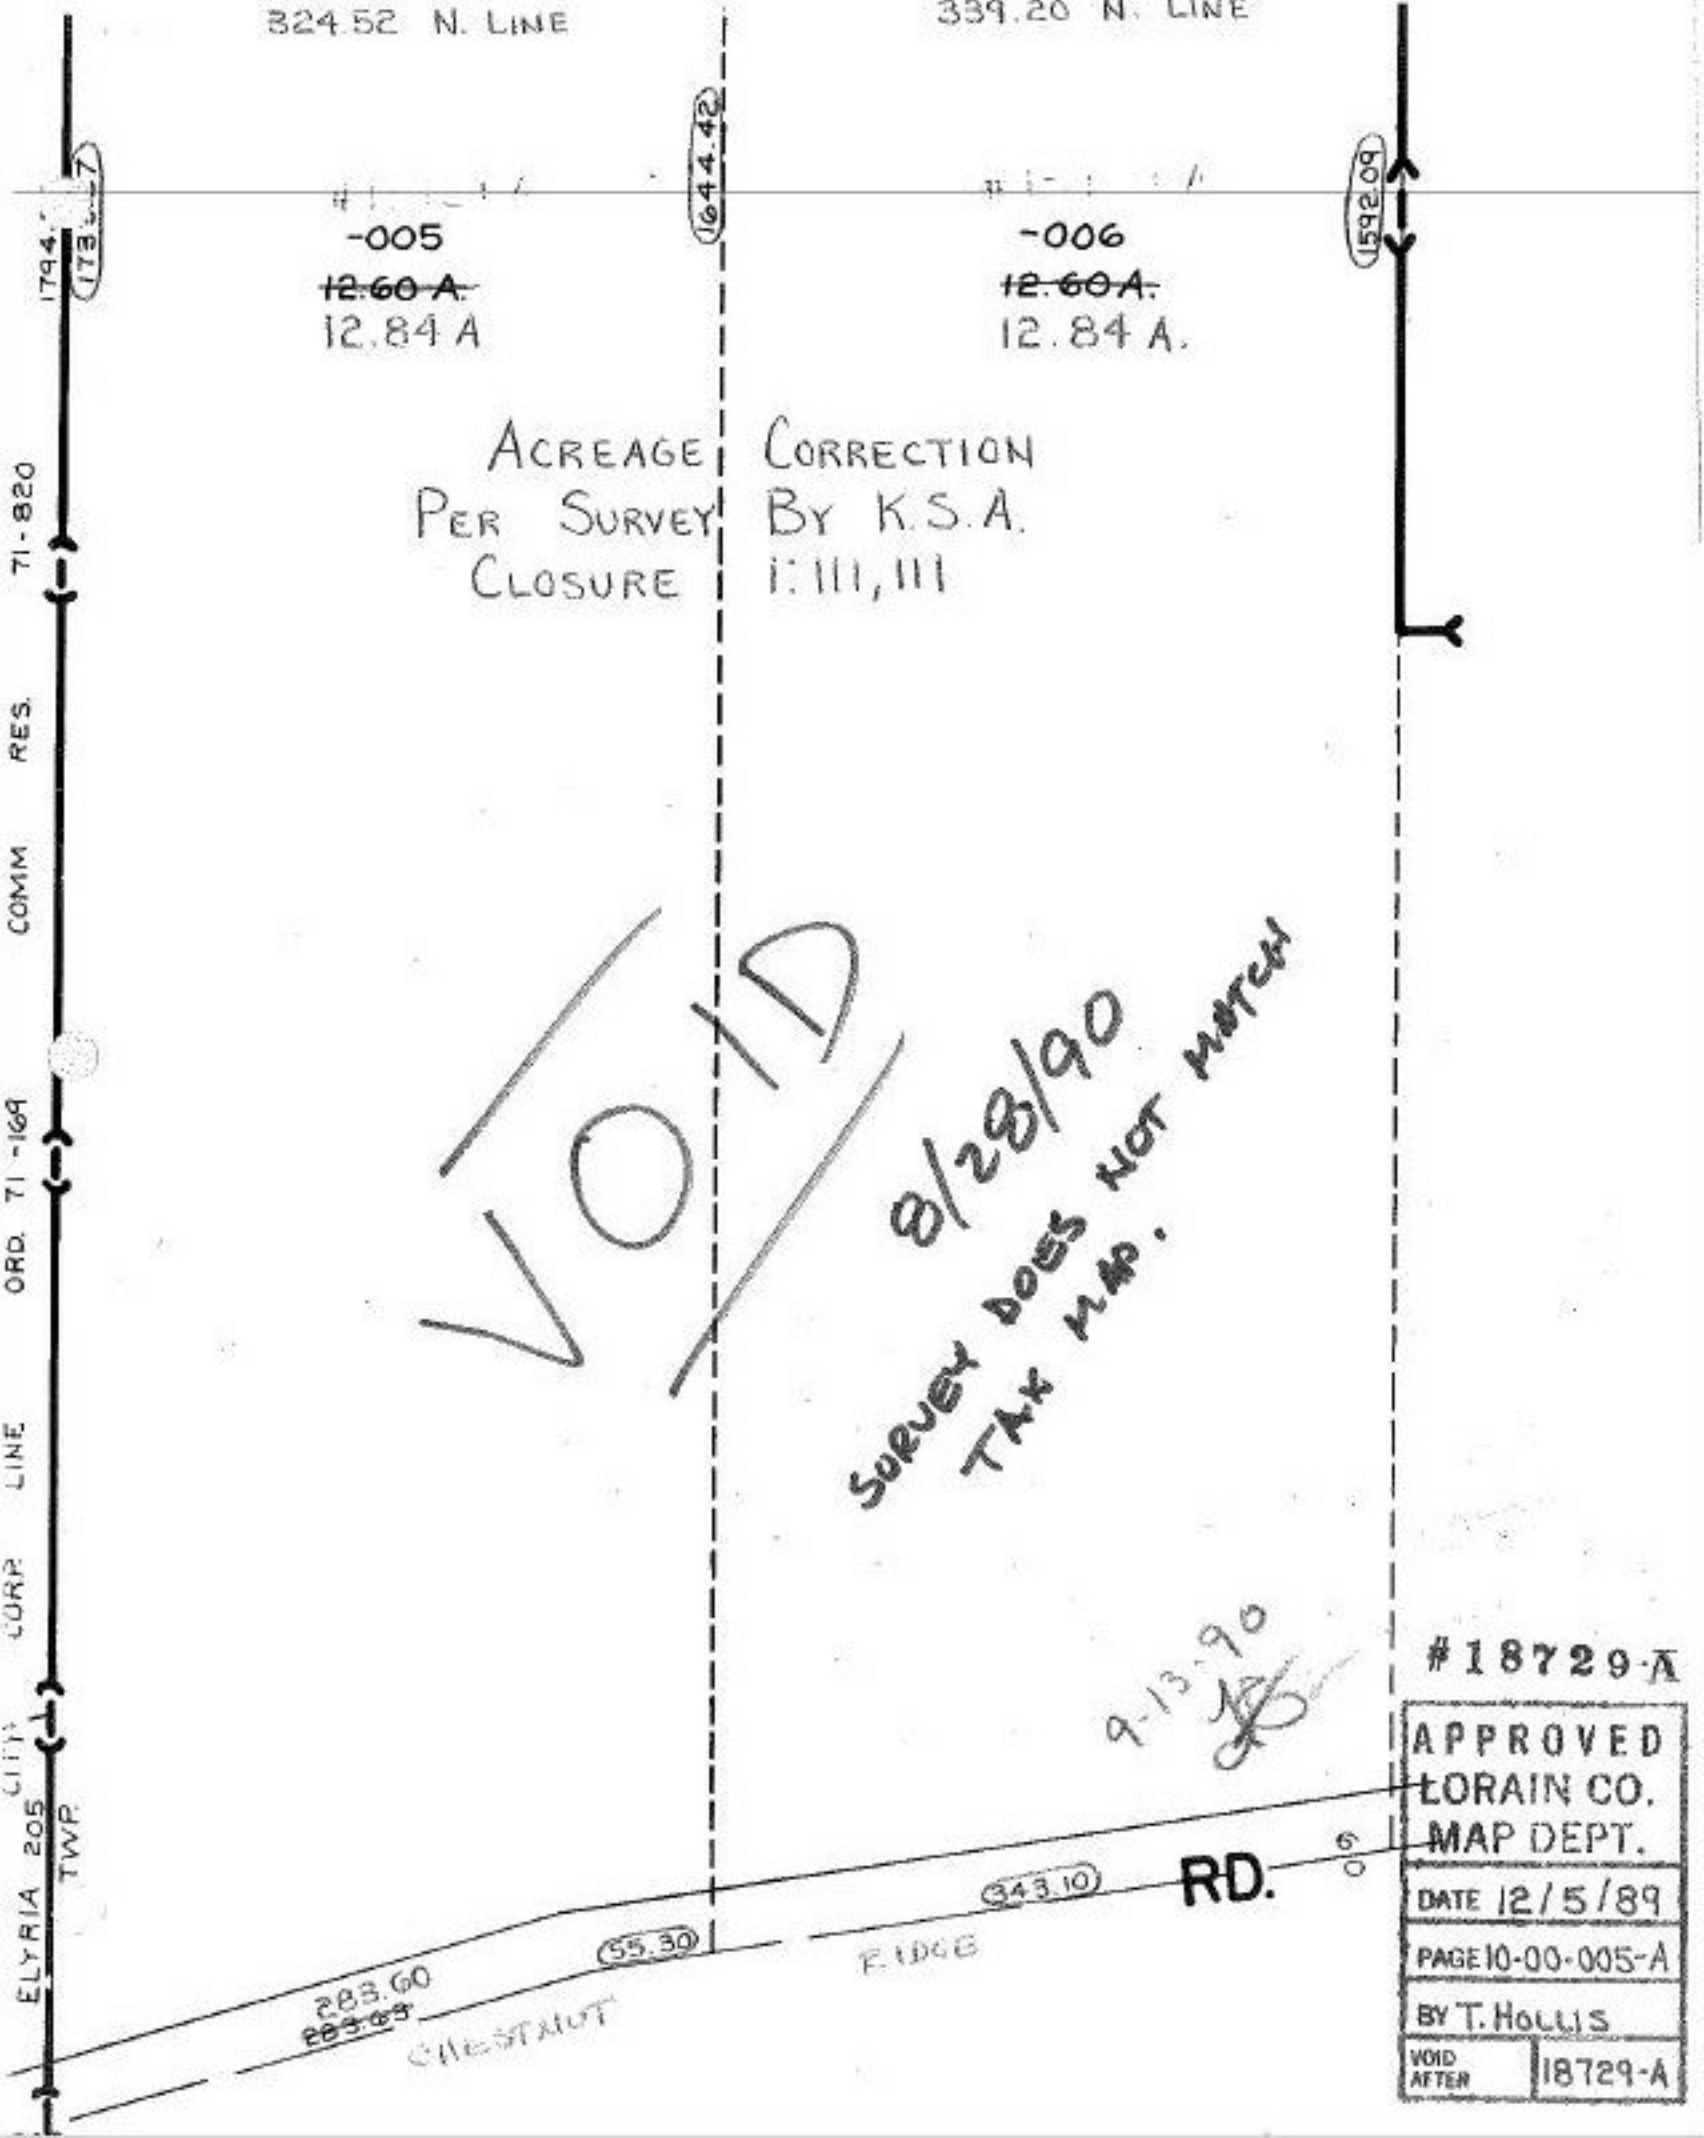

ELYRIA 205 TWP
CITY
CORP
LINE
ORD. T1-169
RES.
COMM

283.60
~~283.60~~

Chestnut

55.30

EDGE

343.10

RD.

60

1794
173

1644.42

1592.09