

OVERLOOK RD

5.74 A.

SEE DETAIL RD.




72.23
71.34
0.89

146.22
90.04
56.18

0.89
85.43
86.32

01-00-003-128- PRIOR INST. OR.140/653
SURVEYED BY: MICHAEL G. HURA
REG. SURVEYOR
C=1:90,909.

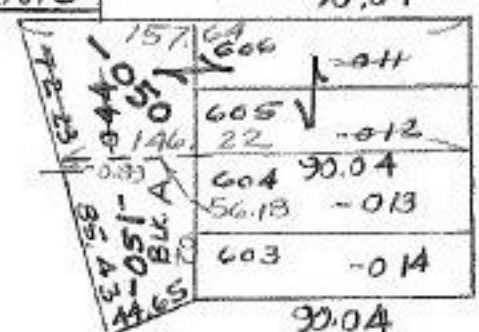

PARK SUB
GUILFORD RD

ANN DR.

MORNINGTON RD.

12/15/89
#18729

APPROVED
LORAIN CO.
MAP DEPT.
DATE 11-20-89
PAGE 1-0003-C
BY CAROLYN FRANCIS
VOID AFTER \$ 18729

-00-003-D

70.03

2.5.