


SEE 11-00-019-B

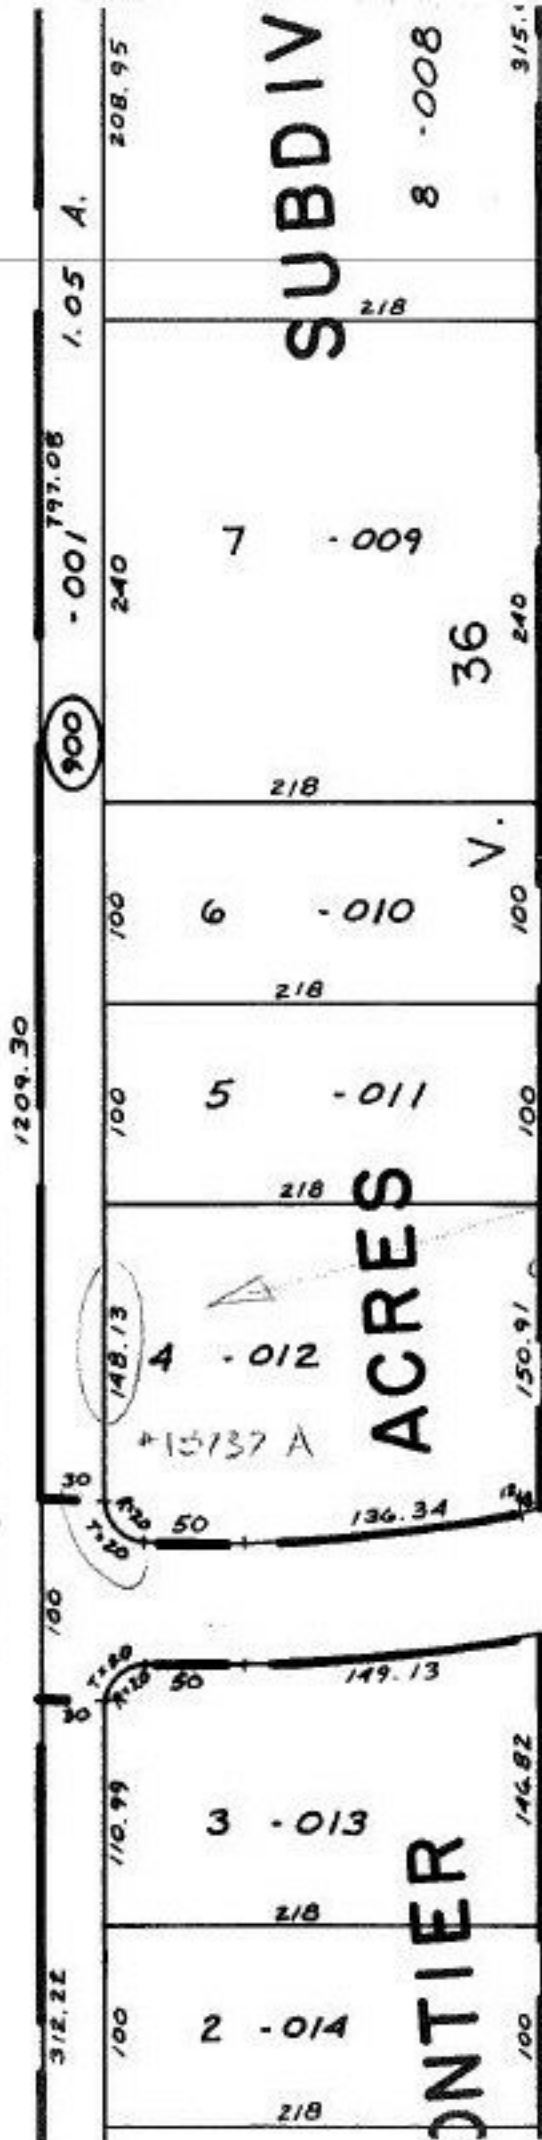

Pt. - 016  
Pt. 95.97

NO MAP CHANGES  
NECESSARY

SH 12/15/89  
#18737-A

PARCEL SIZE CORRECTION

APPROVED	
LORAIN CO.	
MAP DEPT.	
DATE 11-27-89	
PAGE 11-00-002-A	
BY T. Markin	
VOID AFTER	18737-A