

SEE 11-00-048-A

Pt. -026
Pt. 33.64 A.


SEG SURVEY MAP
K. S. ASSOC.
cc. D. INF
PRIOR INST. REF. - 1211/579

48

-043
57.57 A. # 15737
-041
61.59 A.

-023

COOLEY

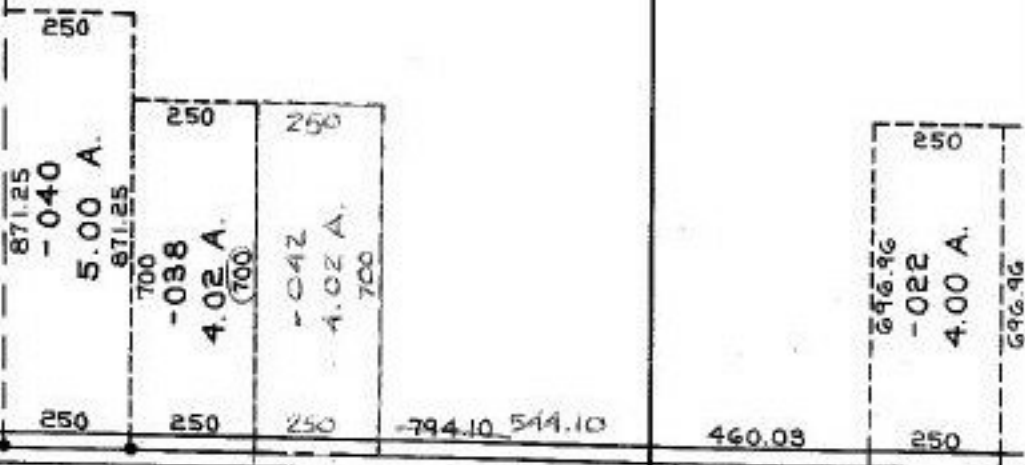

12/15/89 #18737

APPROVED
LORAIN CO.
MAP DEPT.
DATE 11-29-89
PAGE 11-C
T. McVair
18737

300
-040
150 1.03 A.
-041
150 1.03 A.
300
775.10
150 -002 1.36 A. 80
704.23

97-A

97-B