


SEE SURVEY MAP BY  
 KLEINODER-SCHMIDT & ASSOC.  
 C.L. PLINIF  
 PRIOR INST. REF.

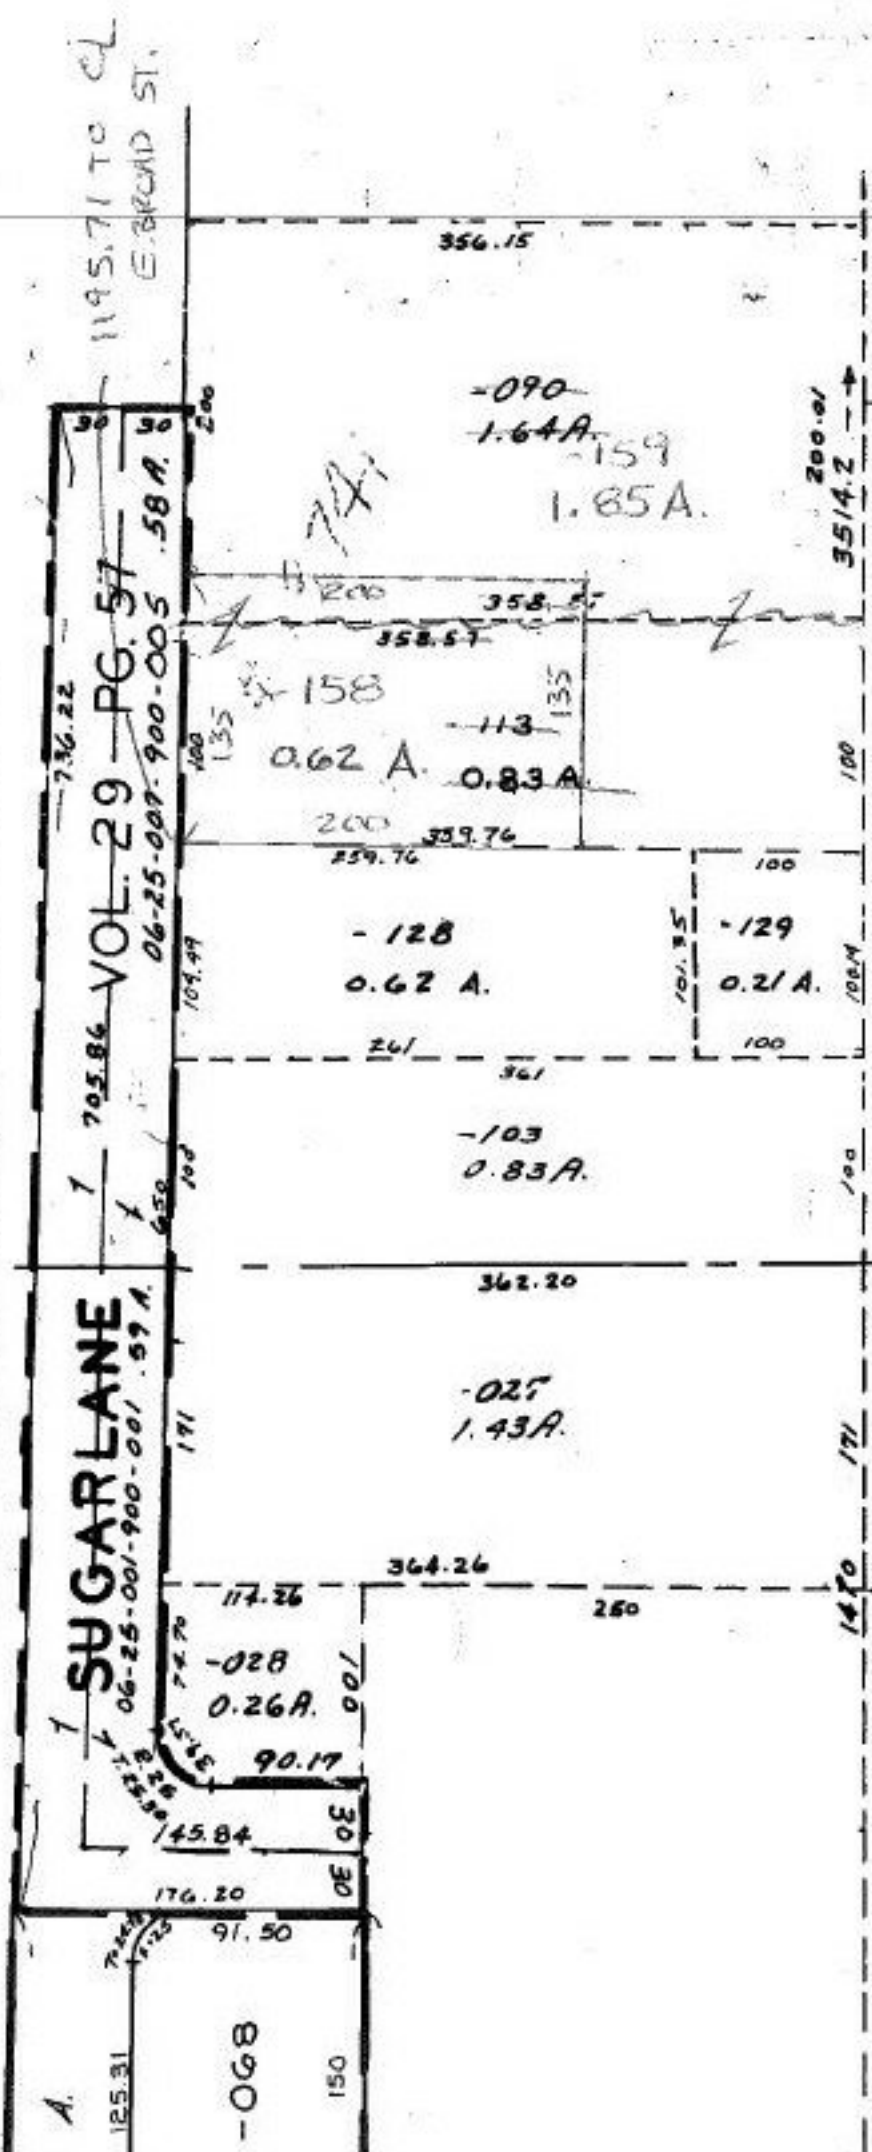

SEE 6-126

7

-046  
 0.99 A.  
 12/20/89  
 #18741

APPROVED  
 LORAIN CO.  
 MAP DEPT.  
 DATE 11-29-89  
 PAGE 6 144  
 BY T. McVain  
 VOID AFTER 18741