

57


00-091-500-001

PT. 60.48 A.

-017  
1.70 A.

THIS AREA  
RE DRAWN  
FROM DEEDS

ALL THESE LOTS  
HAD TO SHIFT  
TO THE SOUTH  
TO BE PROPERLY  
TIED INTO P.P.B.  
C.S.G. CORNER 0691

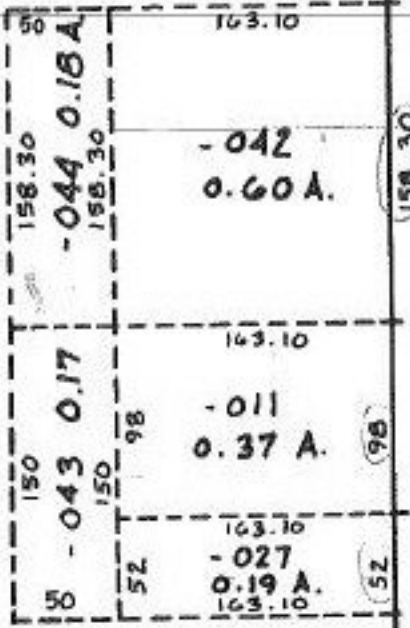

ERHART - NORTHERN

R. R. RD.

4/24/90

251.70

95.80

35.20

18758-B

APPROVED  
FORRAIN CO.  
MAP DEPT.

DATE 3-7-90

PAGE 16-00091-B

BY T. McMain

VOID AFTER 18758-B

MEDINA CO.